

# CITY OF WESTMORLAND

*DWR/SCDR GRANT #4600015451*

*WATER DISTRIBUTION PIPING*

*REPLACEMENT PROJECT*

*BID No. 2025-01*

*Date: April 4, 2025*

## **ADDENDUM NO. 1**

The bidders are advised that the Contract Documents, Specifications, and Plans for the above referenced project are hereby amended per the statements in this Addendum.

1. Change in Contract Document Bid Form.  
The listing of various bid items has changed. The bidders are hereby notified to replace the Bid Form, as attached to this addendum, as “**Addendum No. 1 - Attachment A**”.
2. As noted in the Title Sheet, the Contractor shall be responsible to contract with a Surveyor to conduct the monument preservation research and survey of the project. The cost of monument preservation shall be included in the mobilization bid item cost.

The County of Imperial Department of Public Works’ County Surveyor requires the preservation of monuments. The Contractor is responsible to provide the survey scope of work as required of the Monument Preservation Report - Pre-construction form (MPR-01) and the Monument Preservation Report - Post-construction form (MPR-02). The MPR-01 and MPR-02 are attached as “**Addendum No. 1 – Attachment B**”.

The MPR-01 scope of work is to be conducted, submitted and approved by County Surveyor prior to the commencement of any construction activities at the project site.

3. Plan Sheets 1 through 7 have been revised to illustrate changes in the Design Plans. The design plans are attached as “**Addendum No. 1 – Attachment C**”.

Plan Sheets 3 and 5 are for future projects. The bidder shall not include these plans as part of their bid.

4. The domestic (USA) manufacturer requirement for pipe fittings and valves as written in the Specifications of the Design Plans shall not apply. There is no specific requirement for the Contractor to abide by the Buy American or purchase of domestic (USA) manufacturers for this project.
5. The cost for the geotechnical testing requirement of pipeline trench backfill and asphalt concrete compaction testing of the pipeline is to be omitted from the Contractors responsibility. The cost of the geotechnical testing will be contracted by the City's construction management consultant for the Project.
6. The Contractor shall be responsible for the construction staking of the new pipeline. The construction staking shall be included in the cost for the mobilization bid item.
7. The Contractor shall be responsible to perform excavation and exposure (pothole) of existing utilities that cross the proposed water pipeline. The horizontal and vertical locations of existing utilities are to be identified and marked on the as-built set of plans. The cost of the pothole scope of work shall be included in the pipeline bid item cost.

There are six (6) known existing sanitary sewer services that cross the new water pipeline along 7<sup>th</sup> Street between G Street and F Street. These services lines are not illustrated on the Design Plans.

There are two (2) known existing sanitary sewer services that cross the new water pipeline along 7<sup>th</sup> Street between G Street and Center Street. These services lines are not illustrated on the Design Plans.

There are three (3) known existing sanitary sewer services that cross the new water pipeline along G Street between 5<sup>th</sup> Street and 6<sup>th</sup> Street. These services lines are not illustrated on the Design Plans.

8. The existing Fire Hydrants are to remain in place. New pipeline connections are to be made to the existing Fire Hydrants. The new pipeline connections are to be paid as part of the water pipeline bid item and valve bid item. The cutting and connection of the new pipeline connection is to be paid as per the Restore the existing Fire Hydrant bid item. This is typical of three (3) Fire Hydrants.

**9. Regarding Pipe trench backfill:**

The asphalt concrete pavement section shall be 4 inches of ½-inch hot mix asphalt concrete over 9 inches of class 2 aggregate base.


The area of pipeline trench along 7<sup>th</sup> Street between H Street and J Street shall not be paved with asphalt concrete pavement. Such trench section is to be backfilled with class 2 aggregate base up to the top of the adjacent pavement surface. Where the new pipeline trench is located outside of asphalt pavement, native soil shall be used to backfill to the top of the adjacent native surface.

- 10.** The awarded bidder (Contractor) and its Subcontractor(s) are to obtain City Business Licenses prior to the issuance of the Notice To Proceed.
- 11.** The location of blow-off valves (stub-out blowoff) illustrated on the Design Plans are illustrated for the Contractor to use for pressure testing and disinfection testing. The Contractor shall install blow-off valves as required for each section of pipeline that is constructed and tested. After testing, each blow-off valve is to be capped. The cost for installation and cap of the blow blow-off valves is to be included in the pipeline bid item cost.
- 12.** Since the funding for the project is limited, the following prioritization of piping segments shall be used for construction contract purposes. The sequence of the pipeline construction is to be prioritized in the following order.
- a. N. H St. from 7<sup>th</sup> Street to 8<sup>th</sup> Street (approx. 750' of 8" pipe)
  - b. W. 7<sup>th</sup> Street from H Street to I Street plus the tie-in to I Street (approx. 340' of 8" pipe and 80' of 6" pipe)
  - c. W. 7<sup>th</sup> Street from F Street to G½ Street and re-connect 2 fire hydrants (approx. 660' of 8" pipe and 60' of 6" pipe)
  - d. W. 7<sup>th</sup> Street from Center Street to F Street (approx. 440' of 8" pipe)
  - e. N. G Street from 5<sup>th</sup> Street to 6<sup>th</sup> Street plus wharfhead tie-in (approx. 550' of 6" pipe)
  - f. W. 7<sup>th</sup> Street from I Street to J Street (approx. 340' of 8" pipe)
- 13.** The City of Westmorland will not provide a staging area for the Contractor. The Contractor is to obtain their own staging area.

- 14. The Contractor is to remove and dispose of the excavated native soil from the project site. The City of Westmorland will not receive any of the native soil.
  
- 15. The pressure testing, chlorination and bacteriological testing services are the responsibility of the Contractor. The cost for such tests are to be included in the pipeline bid item cost.

**END OF ADDENDUM NO. 1**

Prepared by:

  
\_\_\_\_\_  
Juny Marmolejo, P.E.  
Project Engineer  
The Holt Group, Inc.

Date: April 4, 2025.

**Addendum No. 01 Acknowledgement**

The Bidder is responsible for advising any and all subcontractors and suppliers of this addendum. Each bidder must acknowledge receipt of this addendum in the noted space below and where indicated in the Bid Form. This sheet of the addendum is to be signed by the Bidder and submitted with the Bid.

Print or Type Bidder's Name: \_\_\_\_\_

Print or Type Authorized Name: \_\_\_\_\_

Authorized Signature of Bidder: \_\_\_\_\_

Date Signed: \_\_\_\_\_

## **Addendum No. 1 – Attachment A**

# CITY OF WESTMORLAND

## PROPOSAL BID SHEET FOR

### WESTMORLAND DWR/SCDR GRANT #4600015451

### WATER DISTRIBUTION PIPING REPLACEMENT PROJECT

BID NO. 2025-01

Item No.	Description	Units	Estimated Quantity	Unit Price	Amount
<b>DEMOLITION</b>					
1	Remove and Dispose/Recycle Existing AC Pavement and PCC Concrete.	L.S.	1	\$ -	\$ -
2	Remove/Dispose Existing Water Valves, abandon and cap Piping as indicated or needed. Maintain water service except for short outages.	L.S.	1	\$ -	\$ -
<b>Demolition SUBTOTAL</b>					\$ -
<b>CONSTRUCTION</b>					
1	Install 8-inch Resilient Wedge Gate Valve (including fittings, piping, and thrust blocks)	EA	7	\$ -	\$ -
2	Install 6-inch Resilient Wedge Gate Valves (including fittings, piping, and thrust blocks)	EA	8	\$ -	\$ -
3	Restore service to existing Fire Hydrants (including tee fitting at main, other fittings including transition coupling to existing pipeline, trenching, and trench backfill)	EA	3	\$ -	\$ -
4	Adjust Water Valve Covers to Grade (including risers, covers, and native material or A.C. as indicated/needed)	EA	20	\$ -	\$ -
5	Install 8-inch C900 PVC water pipe (complete with fittings, concrete thrust blocks, trenching, trench backfill, and pothole) on 7th St. from Center St. to J St. and on N. H St. from 7th St. to 8th St.	LF	2600	\$ -	\$ -
6	Install 6-inch C900 PVC water pipe (complete with fittings, concrete thrust blocks, trenching, trench backfill, and pothole) where shown on Plans	LF	220	\$ -	\$ -
7	Restore Residential Service Laterals	EA	22	\$ -	\$ -
8	AC paving/trench repair as shown in trench paving detail in plans	SF	4600	\$ -	\$ -
9	Traffic control, Sweeping/cleaning, and Notification of water outage	LS	1	\$ -	\$ -
10	Mobilization/demobilization, Replacing Pavement Markings, Install Project Sign, Monument Preservation, and Construction Staking	LS	1	\$ -	\$ -
11	Bonds and Insurance	LS	1	\$ -	\$ -
<b>Construction SUBTOTAL</b>					\$ -
<b>Based Bid Construction and Demolition - TOTAL</b>					\$ -
<b>Additive Bid Item</b>					
A	Install 6-inch C900 PVC water pipe (complete with fittings, concrete thrust blocks, trenching, and trench backfill) [G St. 5th to 6th]	LF	550	\$ -	\$ -
<b>Additive Bid Construction - TOTAL</b>					\$ -

**NOTE: THE QUANTITIES ILLUSTRATED ARE APPROXIMATE. THE ENGINEER WILL NOT ASSUME RESPONSIBILITY FOR THE QUANTITIES ILLUSTRATED. IT IS THE RESPONSIBILITY OF THE CONTRACTOR TO ESTABLISH THE QUANTITIES.**

TOTAL AMOUNT OF BASE BID (NUMBERS)

---

TOTAL AMOUNT OF BASE BID (WORDS)

---

TOTAL AMOUNT OF BASE BID PLUS ADDITIVE (NUMBERS)

---

TOTAL AMOUNT OF BASE BID PLUS ADDITIVE (WORDS)

---

Note: The estimated quantities listed in the Proposal Bid Sheet(s) are supplied to give an indication of the general scope of the work, but the accuracy of these figures is not guaranteed and the bidder shall make his own estimates from the drawings. In case of a variation between the unit price and the totals shown by the bidder, the unit price will be considered to be the bid.

---

Bidder's Name and Telephone Number

Addenda No(s) received

---

**PROPOSAL**

IN WITNESS WHEREOF, BIDDER executes and submits this proposal with the names, titles, hands, and seals of all forenamed principals this \_\_\_\_\_ day of \_\_\_\_\_, 2025.

Bidder: \_\_\_\_\_

By: \_\_\_\_\_

Title: \_\_\_\_\_

Subscribed and sworn to this \_\_\_\_\_ day of \_\_\_\_\_, 2025.

NOTARY PUBLIC \_\_\_\_\_

AGENCY acknowledges this proposal was received and opened at the time and in the place specified, and that it was accompanied by the required guarantee in the amount of ten percent (10%) of the total bid.

By: \_\_\_\_\_

Title: \_\_\_\_\_



**Addendum No. 1 – Attachment B**



County of Imperial  
 Department of Public Works  
 155 S 11th Street  
 El Centro, CA 92243  
 (442) 265-1818

# Monument Preservation Report

## PRE-CONSTRUCTION

FORM  
 MPR-01  
 April 2021

County of Imperial Permit Number/Project Name \_\_\_\_\_

PRIOR TO PERMIT ISSUANCE, THE PERMITTEE SHALL RETAIN THE SERVICE OF A PROFESSIONAL LAND SURVEYOR (OR CIVIL ENGINEER AUTHORIZED TO PRACTICE LAND SURVEYING) WHO WILL BE RESPONSIBLE FOR MONUMENT PRESERVATION AND WHO SHALL PROVIDE A CORNER RECORD (OR RECORD OF SURVEY) TO THE COUNTY SURVEYOR AS REQUIRED BY THE PROFESSIONAL LAND SURVEYORS' ACT, IF APPLICABLE. THE PERMITTEE IS RESPONSIBLE FOR THE COST OF RESTORING, OR REPLACING ALL SURVEY MONUMENTS THAT ARE DISTURBED, OR DESTROYED BY CONSTRUCTION.

(REFERENCE SECTION 8771 OF THE CALIFORNIA BUSINESS AND PROFESSIONS CODE)

\*\*\*\*\* **THIS FORM TO BE COMPLETED BY A PERSON AUTHORIZED TO PRACTICE LAND SURVEYING** \*\*\*\*\*

THE TYPE OF CONSTRUCTION PROPOSED WILL NOT AFFECT ANY SURVEY MONUMENTS.  
 (This box is checked for projects that are proposing no demolition, trenching, excavation, surfacing, etc.)

NAME	P.L.S./R.C.E.	SIGNATURE	DATE	(SEAL)
------	---------------	-----------	------	--------

THE TYPE OF CONSTRUCTION MAY AFFECT SURVEY MONUMENTS.  
 (This box is checked for projects that are proposing demolition, trenching, excavation, surfacing, etc.)

I HAVE INSPECTED THE SITE(S) AND: (check all that apply) DATE OF INSPECTION: \_\_\_\_\_

- MONUMENT(S) AND/OR CORNER ACCESSORY(IES) WERE FOUND WITHIN THE LIMITS OF WORK WHICH I DETERMINED MAY BE DISTURBED OR DESTROYED. **(A corner record or record of survey is required.)** The found monument(s) and/or corner accessory(ies) were referenced and pre-construction corner record(s) (or record(s) of survey) showing the references has been filed with the County Surveyor for the project site(s). The filed corner record(s) (or record(s) of survey) is attached hereto. Also attached, (if not documented on the corner record(s) (or record(s) of survey)) is a sketch/diagram showing locations of monuments that were searched for and not found. I have placed "S.N.F." on the sketch/diagram for each monument and/or corner accessory that was not found. Photos may also be included.
- NO MONUMENT(S) AND/OR CORNER ACCESSORY(IES) WERE FOUND WITHIN THE LIMITS OF WORK. **(No corner record or record of survey is required.)** Attached is a sketch/diagram showing the limits of work and its relationship to the locations of any monument and/or corner accessory searched for and not found. I have placed "S.N.F." on the sketch/diagram for each monument and/or corner accessory not found. Photos may also be included.
- MONUMENT(S) AND/OR CORNER ACCESSORY(IES) WERE FOUND OUTSIDE THE LIMITS OF WORK WHICH I DETERMINED WILL REMAIN PROTECTED IN PLACE. **(No corner record or record of survey is required.)** Attached is a sketch/diagram of the work limits and its relationship to the found monuments. Photos may also be included.
- MONUMENT(S) AND/OR CORNER ACCESSORY(IES) WERE FOUND WITHIN THE LIMITS OF WORK WHICH I DETERMINED MAY BE DISTURBED OR DESTROYED, HOWEVER AN EXISTING CORNER RECORD (OR RECORD OF SURVEY) WHICH SHOWS SUFFICIENT REFERENCES HAS ALREADY BEEN FILED AND THERE IS NO DISCREPANCY ON THE FILED CORNER RECORD (OR RECORD OF SURVEY).

SOURCE(S) OF SURVEY DATA CONSULTED: (Final Maps, Parcel Maps, Records of Survey, private field notes, etc.)

FILED CORNER RECORD# \_\_\_\_\_ OR FILED RECORD OF SURVEY# \_\_\_\_\_

NAME	P.L.S./R.C.E.	SIGNATURE	DATE	(SEAL)
------	---------------	-----------	------	--------



County of Imperial  
 Department of Public Works  
 155 S 11th Street  
 El Centro, CA 92243  
 (442) 265-1818

# Monument Preservation Report

## POST-CONSTRUCTION

FORM  
 MPR-02  
 April 2021

County of Imperial Permit Number/Project Name \_\_\_\_\_

PRIOR TO ISSUING A NOTICE OF COMPLETION FOR PERMITTED CONSTRUCTION, THE PERMITTEE SHALL RETAIN THE SERVICE OF A PROFESSIONAL LAND SURVEYOR (OR CIVIL ENGINEER AUTHORIZED TO PRACTICE LAND SURVEYING) WHO WILL BE RESPONSIBLE FOR MONUMENT RESTORATION AND WHO SHALL PROVIDE A CORNER RECORD (OR RECORD OF SURVEY) TO THE COUNTY SURVEYOR AS REQUIRED BY THE PROFESSIONAL LAND SURVEYORS' ACT, IF APPLICABLE. THE PERMITTEE IS RESPONSIBLE FOR THE COST OF RESTORING, OR REPLACING ALL SURVEY MONUMENTS THAT ARE DISTURBED, OR DESTROYED BY CONSTRUCTION.

(REFERENCE SECTION 8771 OF THE CALIFORNIA BUSINESS AND PROFESSIONS CODE)

\*\*\*\*\* **THIS FORM TO BE COMPLETED BY A PERSON AUTHORIZED TO PRACTICE LAND SURVEYING** \*\*\*\*\*

MONUMENTS AND/OR CORNER ACCESSORY(IES) WERE PROTECTED IN PLACE AND THE PERMITTED CONSTRUCTION DID NOT DISTURB OR DESTROY ANY SURVEY MONUMENTS AND/OR CORNER ACCESSORY(IES).

NAME	P.L.S./R.C.E.	SIGNATURE	DATE	(SEAL)
------	---------------	-----------	------	--------


MONUMENT(S) AND/OR CORNER ACCESSORY(IES) WERE DISTURBED AND/OR DESTROYED DURING THE PERMITTED CONSTRUCTION. A new monument(s) was set in the surface of the new construction or a witness monument(s) was set to perpetuate the original location of the disturbed or destroyed monument(s) and a post-construction corner record or a record of survey was filed in the office of the County Surveyor. (New corner accessory(ies) may also be required.)

FILED CORNER RECORD# \_\_\_\_\_ OR FILED RECORD OF SURVEY# \_\_\_\_\_

NAME	P.L.S./R.C.E.	SIGNATURE	DATE	(SEAL)
------	---------------	-----------	------	--------


**Addendum No. 1 – Attachment C**



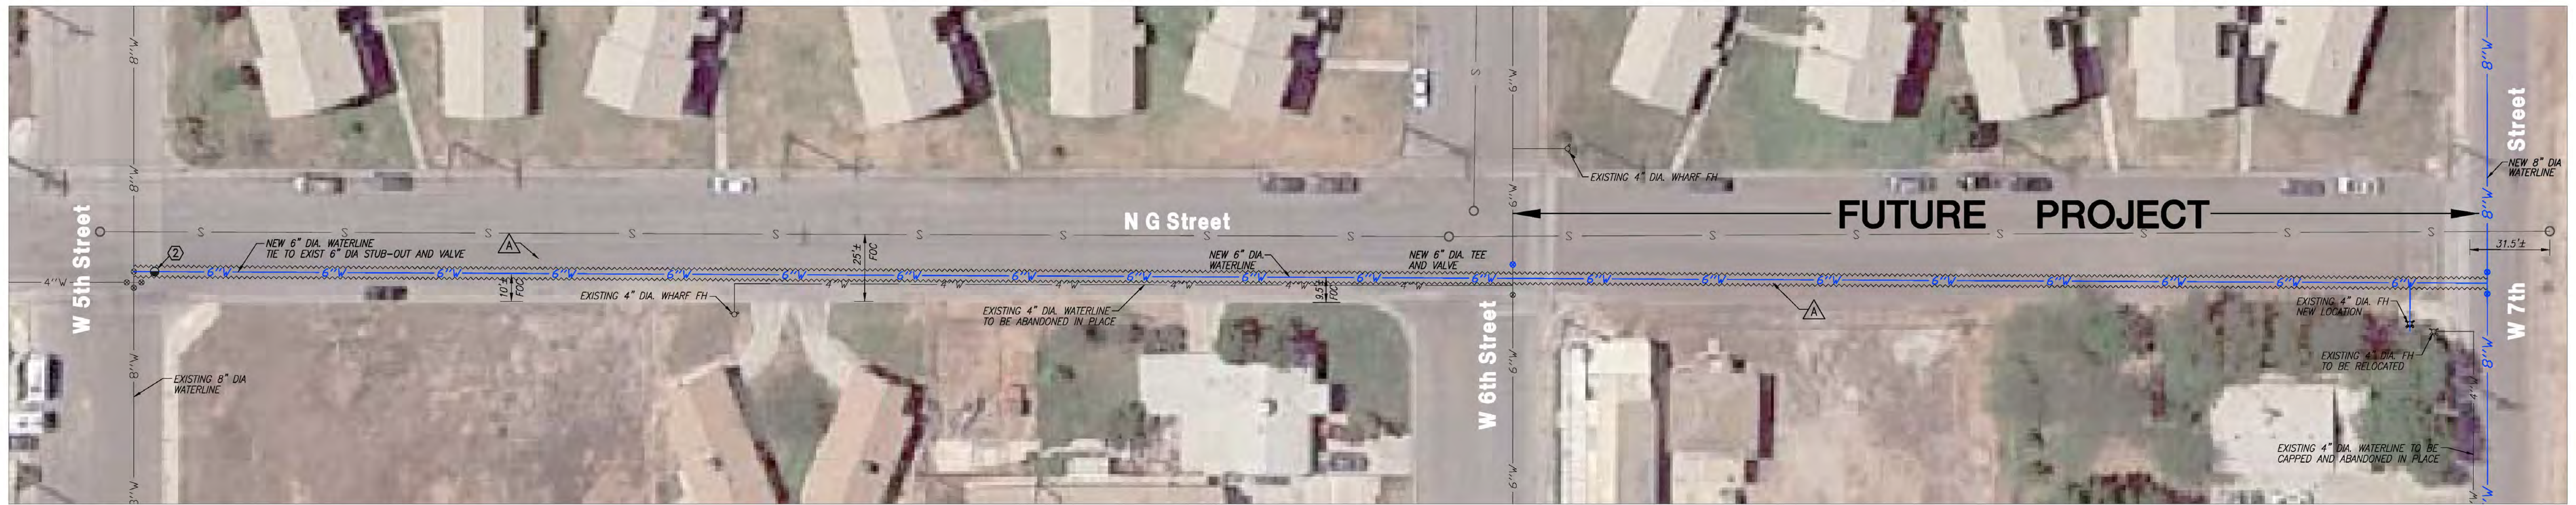

SCALE: 1" = 30'

SCALE: 1" = 30'

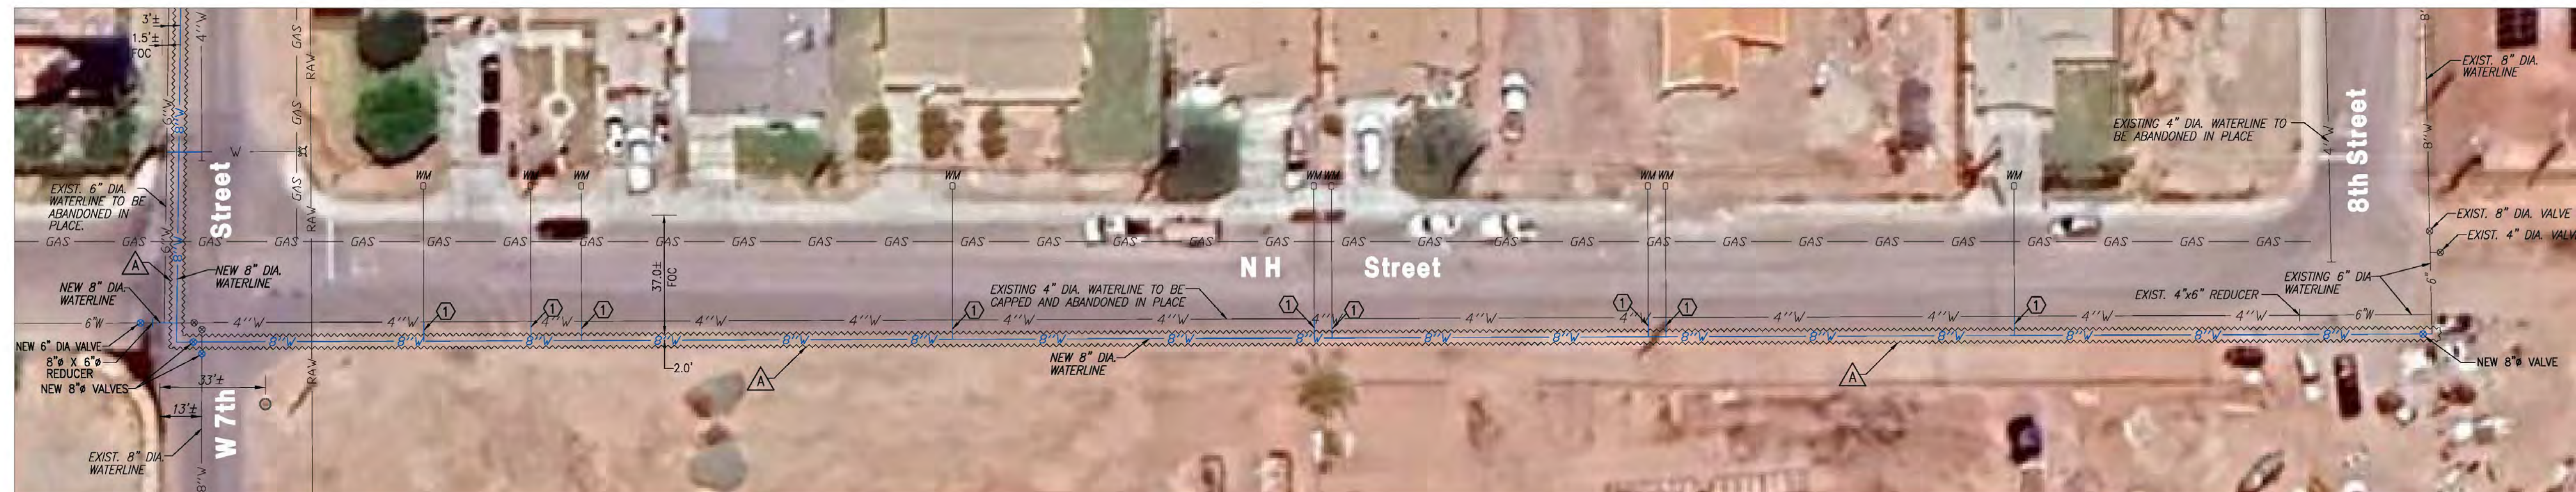

**LEGEND:**

	SAWCUT LINE (EXIST. PAVEMENT)		PROPOSED 6" DIA. WATERLINE
	EXCAVATION LINE (DIRT)		PROPOSED 8" DIA. WATERLINE
	EXIST. SEWER LINE		PROPOSED FIRE HYDRANT
	EXIST. 4" DIA. WATERLINE		PROPOSED BLOWOFF
	EXIST. 6" DIA. WATERLINE		EXIST. FIRE HYDRANT
	EXIST. 8" DIA. WATERLINE		EXIST. FIRE DEPT. CONNECTION
	EXIST. IID RAW WATERLINE		FACE OF CURB
			EXISTING WATER SERVICE

**DEMOLITION KEYNOTES:**

- SAWCUT EXISTING PAVEMENT REMOVE, AND DISPOSE OF EXIST. AC LOCATION: AS INDICATED ON PLANS
- DIRT EXCAVATION LINE LOCATION: AS INDICATED ON PLANS

**WATER NOTE:**


WATER SERVICES: THE CITY OF WESTMORLAND AND CONTRACTOR TO COORDINATE WATER SERVICES LOCATION AND/OR REPLACEMENT OF EXISTING WATER SERVICES.

**WATER KEYNOTES:**


- INSTALL 8" DIA. PVC C-900 DR. 18 WATER LINE (2/6)
- INSTALL 6" DIA. PVC C-900 DR. 18 WATER LINE (6/6)
- FIRE HYDRANT PER DETAIL (3/6)
- INSTALL 8" WATER VALVE
- INSTALL 6" WATER VALVE
- ADJUST TO GRADE EXIST. WATER VALVE, AS NECESSARY
- ① RECONNECT WATER SERVICE PER DETAIL (4/6)
- ② INSTALL STUB-OU BLOWOFF PER DETAIL (7)

<p>CALL BEFORE  YOU DIG TWO WORKING DAYS BEFORE YOU DIG</p>	<p><b>UNDERGROUND SERVICE ALERT</b> CALL: TOLL FREE 811</p>	<p><b>APPROVED BY PUBLIC WORKS DIRECTOR</b> CITY OF WESTMORLAND BY: RAMIRO BARAJAS      DATE: _____</p>	<p><b>ENGINEER OF RECORD</b> PLANS PREPARED UNDER THE SUPERVISION OF BY: ROBERTO C. MARTINEZ      DATE: _____ R.C.E. NO.: 74475</p>		<table border="1" style="width: 100%; border-collapse: collapse;"> <thead> <tr> <th>NO.</th> <th>REVISION</th> <th>DATE</th> <th>BY</th> </tr> </thead> <tbody> <tr><td> </td><td> </td><td> </td><td> </td></tr> <tr><td> </td><td> </td><td> </td><td> </td></tr> <tr><td> </td><td> </td><td> </td><td> </td></tr> </tbody> </table>	NO.	REVISION	DATE	BY													<p><b>BJ</b> <b>ENGINEERING &amp; SURVEYING, INC.</b> Phone (760) 353-3552    341 WEST CROWN CT, STE 100 Fax (760) 353-3751    IMPERIAL, CA 92251</p>	<p><b>DWR-SCDRP- Water Distribution Piping Replacement</b> SHEET <b>2</b> <b>N 'G' STREET BETWEEN W 5th STREET AND W 7th STREET,</b> <b>N 'H' STREET BETWEEN W 7th STREET AND W 8th STREET</b> OF: <b>7</b> IN THE CITY OF WESTMORLAND, CA    DATE: 12/12/2024    BY: R.W. CLIENT: CITY OF WESTMORLAND    JOB NO.: 23-105</p>
NO.	REVISION	DATE	BY																				

SCALE: 1" = 30'

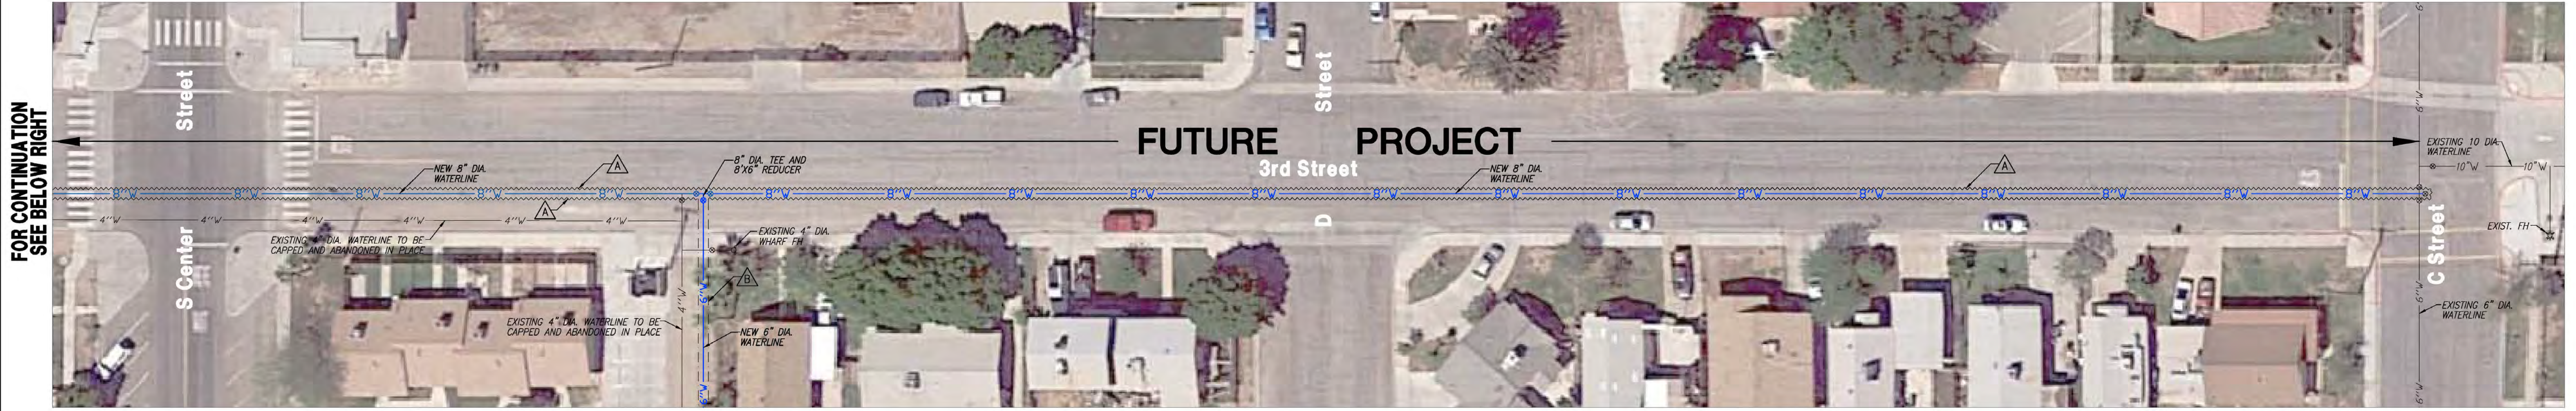

SCALE: 1" = 30'

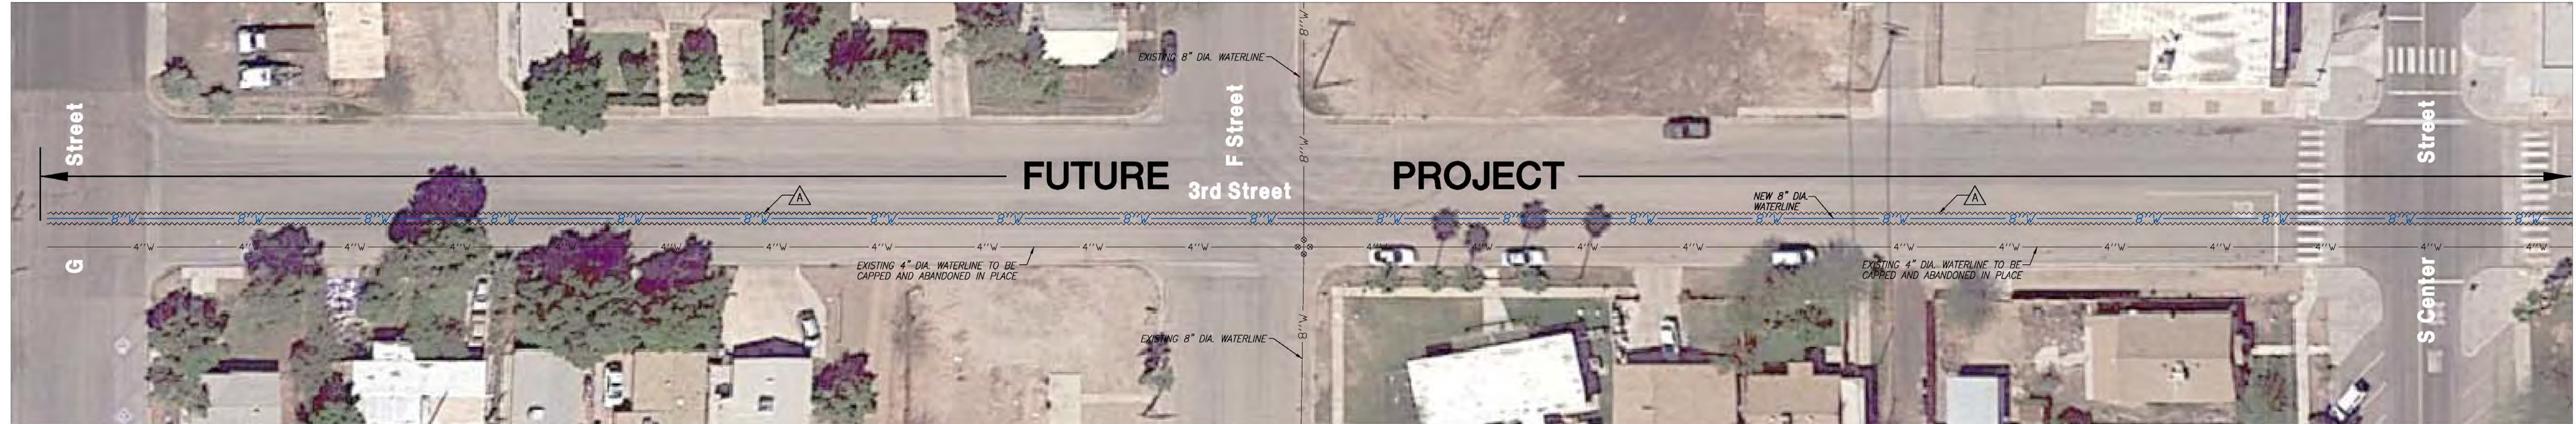

**LEGEND:**

- ~~~~~ SAWCUT LINE (EXIST. PAVEMENT)
- - - - - EXCAVATION LINE (DIRT)
- - - - - EXIST. SEWER LINE
- 4"W EXIST. 4" DIA. WATERLINE
- 6"W EXIST. 6" DIA. WATERLINE
- 8"W EXIST. 8" DIA. WATERLINE
- RAW EXIST. IID RAW WATERLINE
- 6"W PROPOSED 6" DIA. WATERLINE
- 8"W PROPOSED 8" DIA. WATERLINE
- ⊕ PROPOSED FIRE HYDRANT
- ⊙ PROPOSED BLOWOFF
- ⊕ EXIST. FIRE HYDRANT
- ⊕ EXIST. FIRE DEPT. CONNECTION
- FOC FACE OF CURB
- WM EXISTING WATER SERVICE

**DEMOLITION KEYNOTES:**

- ⊕ SAWCUT EXISTING PAVEMENT REMOVE, AND DISPOSE OF EXIST. AC LOCATION: AS INDICATED ON PLANS
- ⊕ DIRT EXCAVATION LINE LOCATION: AS INDICATED ON PLANS

**WATER NOTE:**

WATER SERVICES: THE CITY OF WESTMORLAND AND CONTRACTOR TO COORDINATE WATER SERVICES LOCATION AND/OR REPLACEMENT OF EXISTING WATER SERVICES.

**WATER KEYNOTES:**

- INSTALL 8" DIA. PVC C-900 DR. 18 WATER LINE (2/6)
- INSTALL 6" DIA. PVC C-900 DR. 18 WATER LINE (2/6)
- FIRE HYDRANT PER DETAIL (3/6)
- INSTALL 8" WATER VALVE
- INSTALL 6" WATER VALVE
- ADJUST TO GRADE EXIST. WATER VALVE, AS NECESSARY
- ① RECONNECT WATER SERVICE PER DETAIL (4/6)
- ② INSTALL STUB-OU BLOWOFF PER DETAIL (1/7)

CALL BEFORE UNDERGROUND SERVICE ALERT CALL: TOLL FREE 811 TWO WORKING DAYS BEFORE YOU DIG

APPROVED BY PUBLIC WORKS DIRECTOR CITY OF WESTMORLAND BY: RAMIRO BARAJAS DATE:

ENGINEER OF RECORD PLANS PREPARED UNDER THE SUPERVISION OF ROBERTO C. MARTINEZ DATE: R.C.E. NO.: 74475




NO.	REVISION	DATE	BY

NOTE: THE ENGINEER'S SEAL AFFIXED BESIDE INDICATES THAT THE METHOD OF ANALYSIS PRESENTED IS CONSISTENT WITH ACCEPTED ENGINEERING PRACTICES AND CODE ACCEPTED DESIGN VALUES AND THAT THIS ENGINEER IS ONLY RESPONSIBLE FOR THE DESIGN OF CIVIL ENGINEERING WORK SHOWN ON THIS PLAN.

**BJ ENGINEERING & SURVEYING, INC.**  
 Phone (760) 353-3552 341 WEST CROWN CT, STE 100  
 Fax (760) 353-3751 IMPERIAL, CA 92251


DWR-SCDRP- Water Distribution Piping Replacement SHEET 3 OF 7  
**3RD STREET BETWEEN C STREET AND G STREET**  
**3RD STREET BETWEEN G STREET AND S CENTER STREET**  
 IN THE CITY OF WESTMORLAND, CA DATE: 12/12/2024 BY: R.W.  
 CLIENT: CITY OF WESTMORLAND JOB NO.: 23-105

SCALE: 1" = 30'

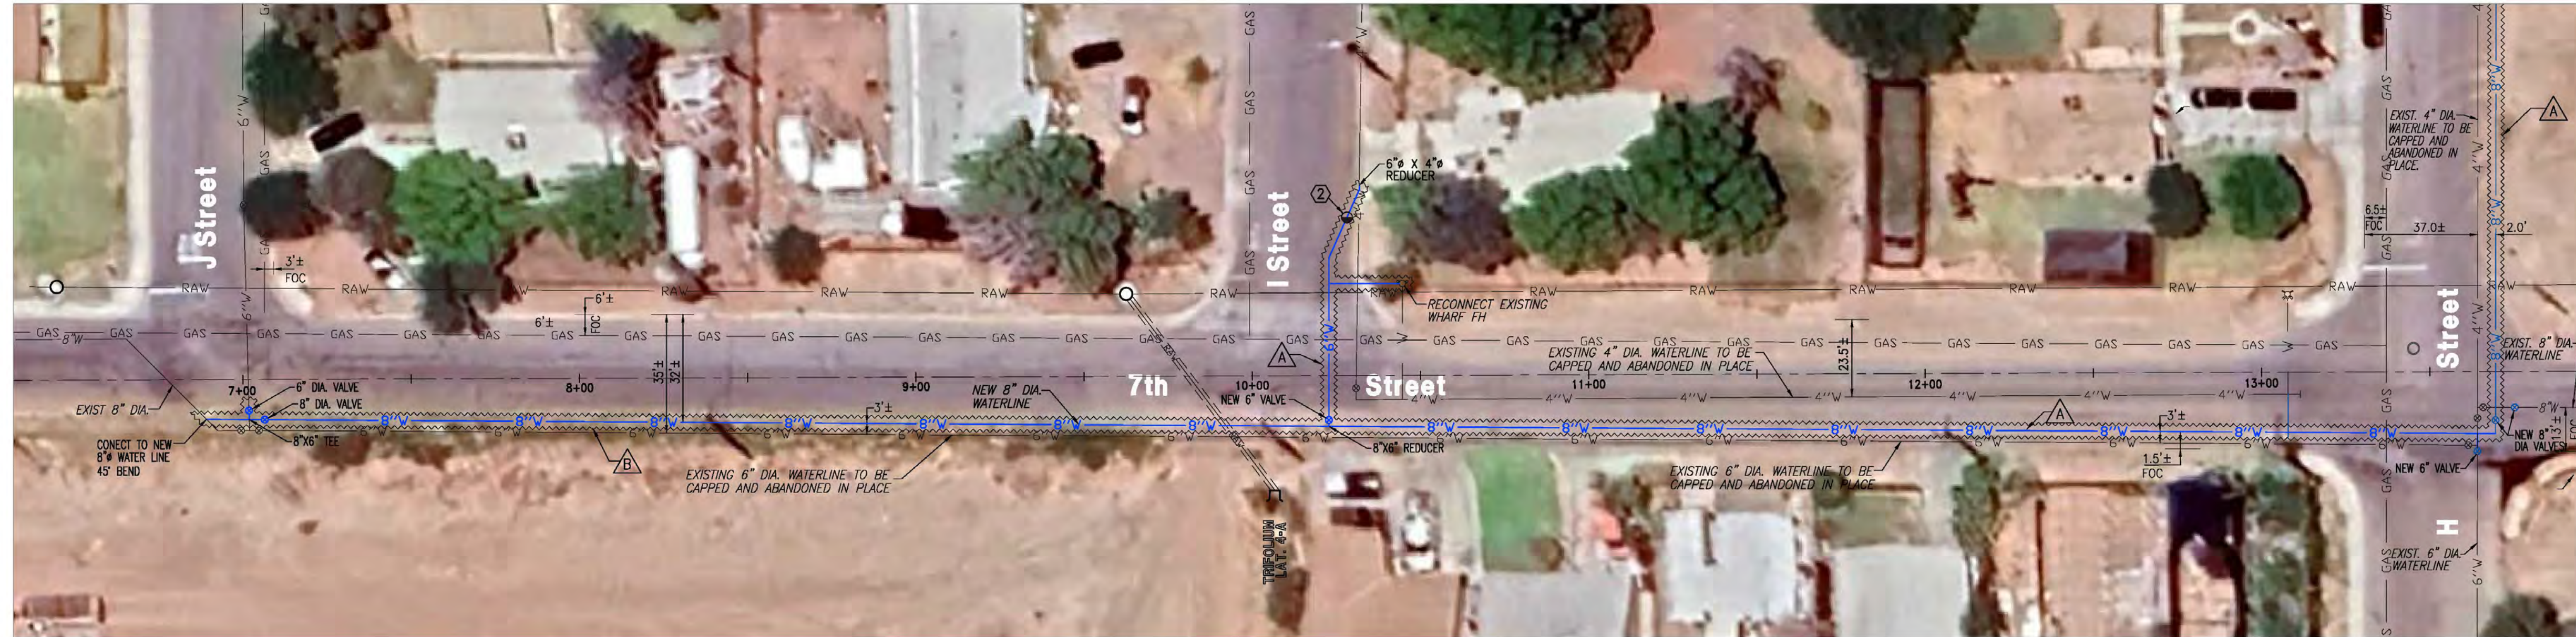

FOR CONTINUATION  
SEE BELOW LEFT


SCALE: 1" = 30'

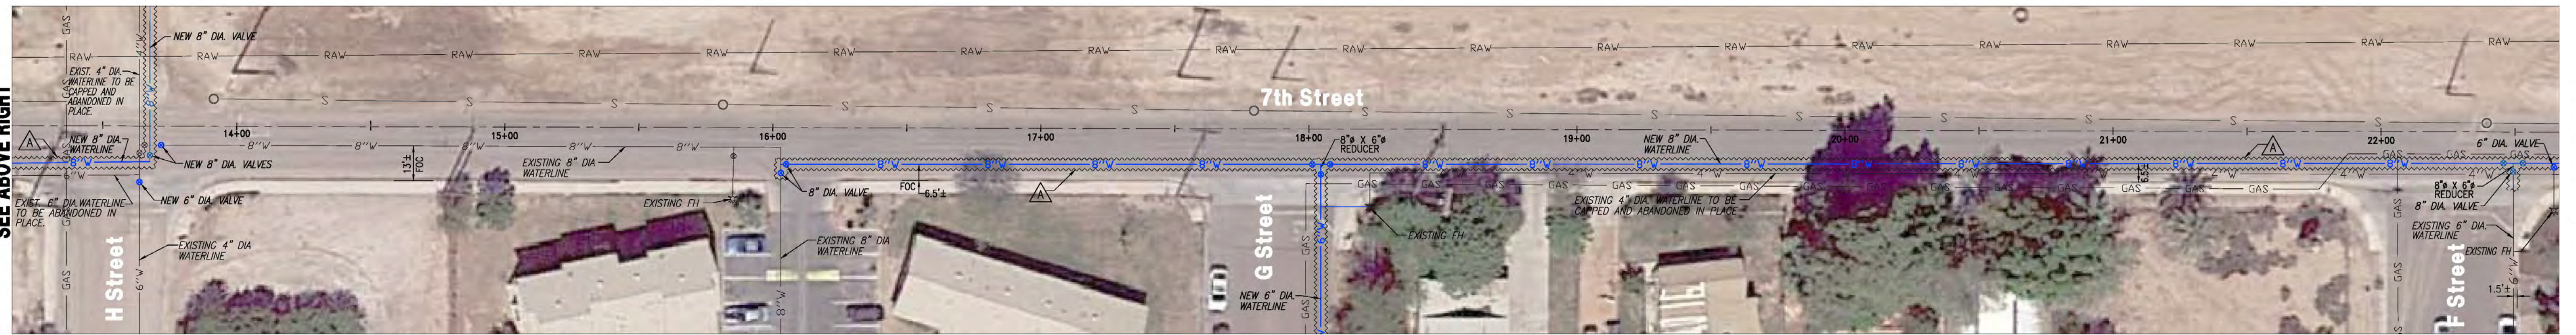

FOR CONTINUATION  
SEE ABOVE RIGHT

FOR CONTINUATION  
SEE BELOW LEFT

SCALE: 1" = 30'

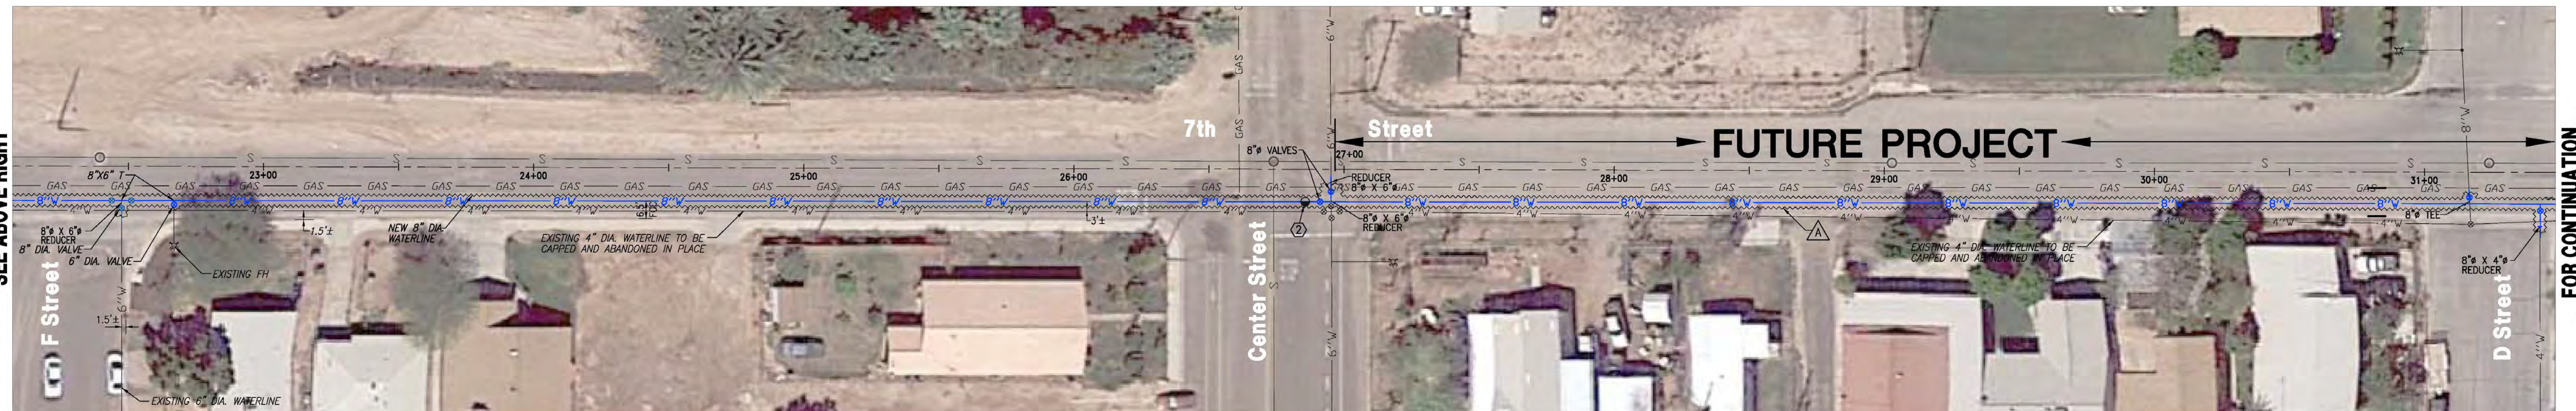

FOR CONTINUATION  
SEE ABOVE RIGHT

FOR CONTINUATION  
SEE SHEET 5 ABOVE LEFT

**LEGEND:**

	SAWCUT LINE (EXIST. PAVEMENT)		
	EXCAVATION LINE (DIRT)		
	EXIST. SEWER LINE		PROPOSED FIRE HYDRANT
	EXIST. IID RAW WATERLINE		PROPOSED BLOWOFF
			EXIST. FIRE HYDRANT
			EXIST. FIRE DEPT. CONNECTION
			FACE OF CURB
			EXISTING WATER SERVICE

**DEMOLITION KEYNOTES:**

- SAWCUT EXISTING PAVEMENT REMOVE, AND DISPOSE OF EXIST. AC LOCATION: AS INDICATED ON PLANS
- DIRT EXCAVATION LINE LOCATION: AS INDICATED ON PLANS

**WATER NOTE:**

WATER SERVICES: THE CITY OF WESTMORLAND AND CONTRACTOR TO COORDINATE WATER SERVICES LOCATION AND/OR REPLACEMENT OF EXISTING WATER SERVICES.

**WATER KEYNOTES:**

- INSTALL 8" DIA. PVC C-900 DR. 18 WATER LINE
- INSTALL 6" DIA. PVC C-900 DR. 18 WATER LINE
- FIRE HYDRANT PER DETAIL
- INSTALL 8" WATER VALVE
- INSTALL 6" WATER VALVE
- ADJUST TO GRADE EXIST. WATER VALVE, AS NECESSARY
- RECONNECT WATER SERVICE PER DETAIL
- INSTALL STUB-OUT BLOWOFF PER DETAIL

CALL BEFORE  
**UNDERGROUND SERVICE ALERT**  
CALL: TOLL FREE  
811  
TWO WORKING DAYS BEFORE YOU DIG

**APPROVED BY PUBLIC WORKS DIRECTOR**

CITY OF WESTMORLAND  
BY: RAMIRO BARAJAS DATE: \_\_\_\_\_

**ENGINEER OF RECORD**

PLANS PREPARED UNDER THE SUPERVISION OF  
BY: ROBERTO C. MARTINEZ DATE: \_\_\_\_\_  
R.C.E. NO.: 74475




NO.	REVISION	DATE	BY

NOTE: THE ENGINEER'S SEAL AFFIXED BESIDE INDICATES THAT THE METHOD OF ANALYSIS PRESENTED IS CONSISTENT WITH ACCEPTED ENGINEERING PRACTICES AND CODE ACCEPTED DESIGN VALUES AND THAT THIS ENGINEER IS ONLY RESPONSIBLE FOR THE DESIGN OF CIVIL ENGINEERING WORK SHOWN ON THIS PLAN.

**BJ**  
**ENGINEERING & SURVEYING, INC.**  
Phone (760) 353-3552 341 WEST CROWN CT, STE 100  
Fax (760) 353-3751 IMPERIAL, CA 92251

DWR-SCDRP- Water Distribution Piping Replacement SHEET  
**7th STREET BETWEEN J STREET AND D STREET** OF: **4**  
IN THE CITY OF WESTMORLAND, CA DATE: 12/12/2024 BY: R.W.  
CLIENT: CITY OF WESTMORLAND JOB NO.: 23-105



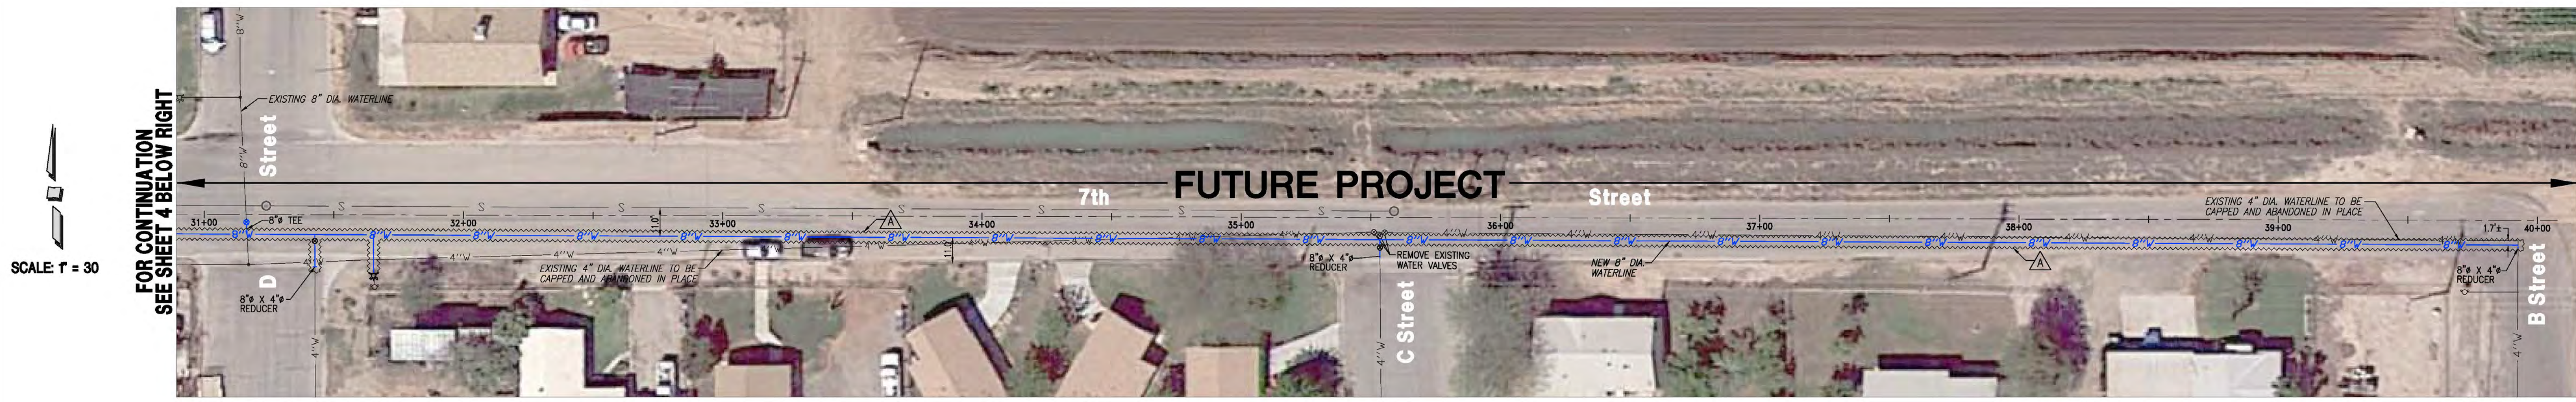


SCALE: 1" = 30'

FOR CONTINUATION SEE SHEET 4 BELOW RIGHT



SCALE: 1" = 30'

FUTURE PROJECT

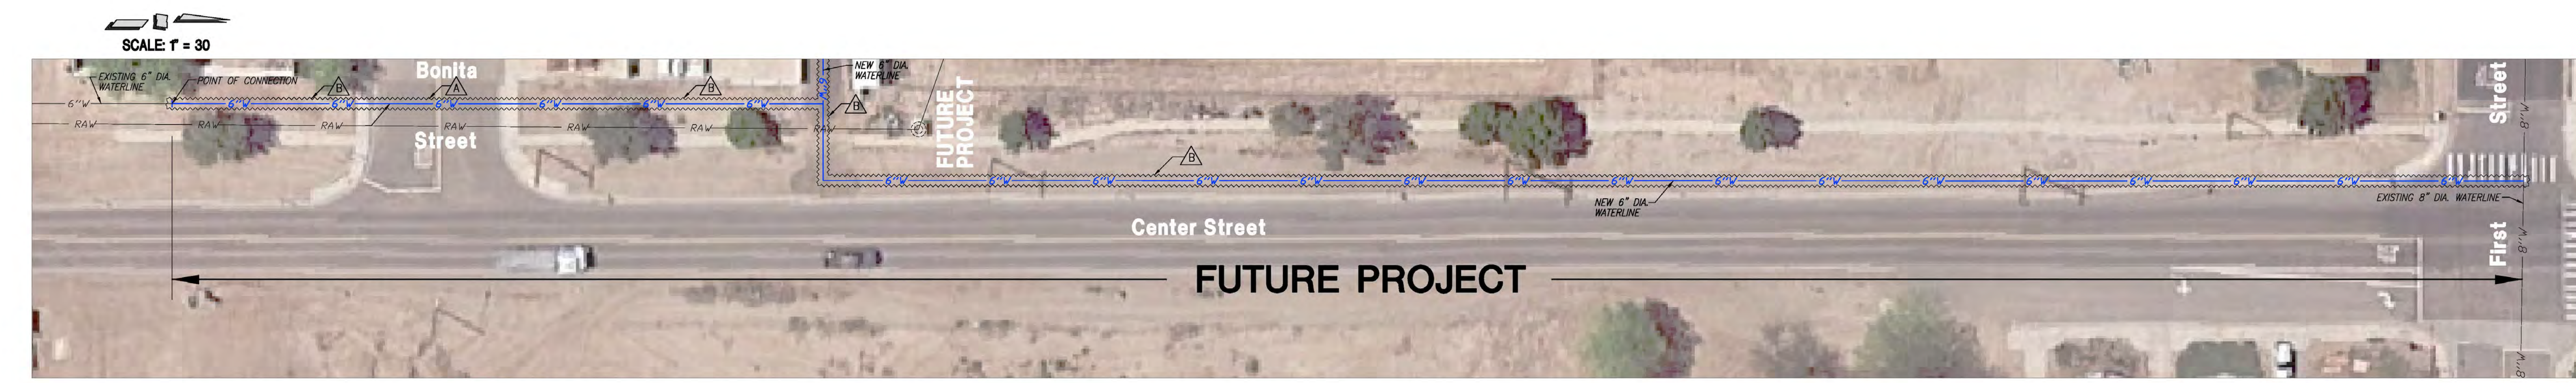

SCALE: 1" = 30'

**LEGEND:**

	SAWCUT LINE (EXIST. PAVEMENT)		PROPOSED 6" DIA. WATERLINE
	EXCAVATION LINE (DIRT)		PROPOSED 8" DIA. WATERLINE
	EXIST. SEWER LINE		PROPOSED FIRE HYDRANT
	EXIST. 4" DIA. WATERLINE		PROPOSED BLOWOFF
	EXIST. 6" DIA. WATERLINE		EXIST. FIRE HYDRANT
	EXIST. 8" DIA. WATERLINE		EXIST. FIRE DEPT. CONNECTION
	EXIST. IID RAW WATERLINE		FACE OF CURB
			EXISTING WATER SERVICE

**DEMOLITION KEYNOTES:**

SAWCUT EXISTING PAVEMENT REMOVE, AND DISPOSE OF EXIST. AC LOCATION: AS INDICATED ON PLANS

DIRT EXCAVATION LINE LOCATION: AS INDICATED ON PLANS

**WATER NOTE:**  
WATER SERVICES: THE CITY OF WESTMORLAND AND CONTRACTOR TO COORDINATE WATER SERVICES LOCATION AND/OR REPLACEMENT OF EXISTING WATER SERVICES.

**WATER KEYNOTES:**

INSTALL 8" DIA. PVC C-900 DR. 18" WATER LINE	
INSTALL 6" DIA. PVC C-900 DR. 18" WATER LINE	
FIRE HYDRANT PER DETAIL	
INSTALL 8" WATER VALVE	
INSTALL 6" WATER VALVE	
ADJUST TO GRADE EXIST. WATER VALVE, AS NECESSARY	
① RECONNECT WATER SERVICE PER DETAIL	
② INSTALL STUB-OU BLOWOFF PER DETAIL	

CALL BEFORE UNDERGROUND SERVICE ALERT  
CALL: TOLL FREE 811  
YOU DIG TWO WORKING DAYS BEFORE YOU DIG

APPROVED BY PUBLIC WORKS DIRECTOR  
CITY OF WESTMORLAND  
BY: RAMIRO BARAJAS DATE: \_\_\_\_\_

ENGINEER OF RECORD  
PLANS PREPARED UNDER THE SUPERVISION OF  
BY: ROBERTO C. MARTINEZ DATE: \_\_\_\_\_  
R.C.E. NO.: 74475



NO.	REVISION	DATE	BY

NOTE: THE ENGINEER'S SEAL AFFIXED BESIDE INDICATES THAT THE METHOD OF ANALYSIS PRESENTED IS CONSISTENT WITH ACCEPTED ENGINEERING PRACTICES AND CODE ACCEPTED DESIGN VALUES AND THAT THIS ENGINEER IS ONLY RESPONSIBLE FOR THE DESIGN OF CIVIL ENGINEERING WORK SHOWN ON THIS PLAN.

**BJ**  
**ENGINEERING & SURVEYING, INC.**  
Phone (760) 363-3552 341 WEST CROWN CT, STE 100  
Fax (760) 353-3751 IMPERIAL, CA 92251

DWR-SCDRP- Water Distribution Piping Replacement  
7th STREET BETWEEN D STREET AND B STREET,  
ALLEY BONITA BETWEEN COOK STREET AND CENTER STREET,  
CENTER STREET BETWEEN BONITA STREET AND 1ST STREET  
IN THE CITY OF WESTMORLAND, CA DATE: 12/12/2024  
CLIENT: CITY OF WESTMORLAND JOB NO.: 23-105

SHEET 5 OF 7  
BY: R.W.

**PVC POTABLE WATER SPECIFICATIONS**

- STANDARDS - STANDARD TO BE USED SHALL MEAN THOSE STANDARDS OF THE AMERICAN WATER WORKS ASSOCIATION IN EFFECT ON JANUARY 1, 1999. SAID STANDARDS ARE AVAILABLE FROM THE BOOKSTORE OF SAID ASSOCIATION, 6666 W. QUINCY AVENUE, DENVER, CO 80235 (800) 926-7337.
- MATERIALS OF CONSTRUCTION - ALL WATER PIPE, FITTINGS AND APPURTENANCES CALLED FOR IN THESE CONTRACT DOCUMENTS SHALL CONFORM TO THE FOLLOWING STANDARDS, THOSE OTHER STANDARDS THEREIN REFERENCED AND THESE SPECIAL PROVISIONS.

A.- PIPE: AWWA C-900 AND C-905. PIPE 12 INCHES AND SMALLER SHALL BE CLASS 150, DR-18; LARGER PIPE SHALL BE 235 PSI, DR-18. ALL PIPES SHALL HAVE BELL AND SPIGOT, ELASTOMERIC GASKETED JOINTS. PIPE SHALL BE SUPPLIED WITH AN AFFIDAVIT OF COMPLIANCE.

B.- FITTINGS: AWWA C-153 AND C-104. FITTINGS SHALL BE CEMENT-MORTAR LINED. UNLESS OTHERWISE SHOWN OR INDICATED BY THE CONTRACT DRAWINGS, BENDS SHALL BE FURNISHED WITH MECHANICAL JOINT ENDS; TEES AND CROSSES SHALL BE FURNISHED WITH FLANGED JOINT ENDS. FLANGE TO MECHANICAL JOINT ADAPTERS SHALL BE FURNISHED TO CONNECT PIPE TO TEES AND CROSSES WHERE VALVES DO NOT OCCUR. GLANDS SHALL BE OF THE SAME MANUFACTURER AS FITTINGS.

C.- GATE VALVES: AWWA C-509. VALVES 12 INCHES AND SMALLER SHALL BE RESILIENT-WEDGE GATE, FUSION-BONDED EPOXY COATED INSIDE AND OUT; AND, UNLESS OTHERWISE SHOWN OR INDICATED BY THE CONTRACT DRAWINGS, SHALL BE FURNISHED WITH A MECHANICAL JOINT ONE END AND A FLANGED JOINT THE OTHER. VALVES, WHEN CLOSED, SHALL PROVIDE A BUBBLE-TIGHT SEAL AGAINST LEAKAGE AND SHALL BE OF THE TYPE AND DESIGN THAT ALLOWS REPLACEMENT OF ALL INTERNAL PARTS WITHOUT REMOVING THE VALVE BODY FROM THE PIPELINE. ALL INTERNAL PARTS SHALL BE MATERIALS SUITABLE FOR EXPOSURE TO WATER CONTAINING CHLORINE AS A DISINFECTANT AT VARIOUS CONCENTRATIONS. VALVES SHALL BE SUPPLIED WITH AN AFFIDAVIT OF COMPLIANCE.

E.- DOMESTIC MANUFACTURERS: ALL PIPEFITTINGS AND VALVES SHALL BE THE PRODUCT OF A DOMESTIC (USA) MANUFACTURER.

F.- FIRE HYDRANTS: AWWA C-503. FIRE HYDRANTS SHALL BE OF THE WET-BARREL TYPE, ALL EQUAL TO THAT CALLED OUT IN THE CONTRACT DRAWINGS. THE BURY-ELL, RISERS AND DOUBLE GROOVED BREAK-OFF SPOOLS SHALL BE OF EPOXY COATED INSIDE, DUCTILE IRON. ALL BOLTS USED IN THE FIRE HYDRANT ASSEMBLY SHALL BE OF APPROVED STAINLESS STEEL. THE BURY-ELL SHALL BE SUPPLIED WITH A MECHANICAL JOINT INLET AND FOR CONNECTION OF THE PIPE AND INSTALLATION OF JOINT RESTRAINT DEVICE. ALL HYDRANTS SHALL BE FURNISHED WITH OUTLET CAPS WITH CHAIN AND AN AFFIDAVIT OF COMPLIANCE.

G.- BOLTS: ALL BOLTS USED FOR INSTALLATION OF UNDERGROUND FITTINGS AND VALVES SHALL BE EITHER TEXLAN COATED OR OF APPROVED STAINLESS STEEL.

H.- AIR VALVES: AWWA C-512. ALL AIR-RELEASE VALVES, AIR-VACUUM VALVES AND COMBINATION AIR VALVES SHALL BE OF CAST-IRON BODY WITH INTERNAL PARTS OF STAINLESS STEEL, BUNA-N, DERLIN OR OTHER SIMILAR CORROSION RESISTANT MATERIALS, SUITABLE FOR EXPOSURE TO WATER CONTAINING CHLORINE AS A DISINFECTANT IN VARIOUS CONCENTRATIONS. AIR-VALVES SHALL BE EQUAL TO THAT CALLED OUT IN THE CONTRACT DRAWINGS.

I.- JOINT RESTRAINT DEVICES: ALL MECHANICAL JOINTS INCORPORATED INTO THE CONTRACT PROJECT SHALL BE FITTED WITH JOINT RESTRAINT DEVICES EQUAL TO THOSE MANUFACTURED BY EBA-IRON OF EASTLAND, TEXAS AND SOLD AS THE 2000 PV SERIES, INSTALLED IN FULL CONFORMANCE TO THE MANUFACTURER'S WRITTEN INSTRUCTIONS. THE CONTRACTOR SHALL ALSO FURNISH AND INSTALL SERIES 1600 AND 2800 PIPE JOINT HARNESSES ON A SUFFICIENT NUMBER OF JOINTS AWAY FROM THE JOINT RESTRAINT DEVICE TO INSURE AGAINST SEPARATION OF THE PIPE. A SOIL FRICTION OF 150 PSF MAY BE USED FOR CALCULATING THE NUMBER OF PIPE JOINTS TO WHICH A HARNESS MUST BE APPLIED. FOR 12-INCH PIPE, ALL JOINTS WITHIN 45 FT. MUST BE HARNESSSED; FOR 18-INCH PIPE, ALL JOINTS WITHIN 65 FT. MUST BE HARNESSSED.

J.- EPOXY COATINGS: AWWA C-550. EPOXY COATING CALLED FOR IN THESE SPECIAL PROVISIONS SHALL BE FUSION-BONDED AT THE FACTORY.

K.- PIPE BEDDING AND BACKFILL: GRANULAR MATERIAL FOR PIPE BEDDING AND PIPE ZONE BACKFILL TO NO LESS THAN 12 INCHES ABOVE TOP OF PIPE, SHALL CONSIST OF SAND FREE FROM CLAY OR ORGANIC MATERIAL, 90 TO 100 PERCENT PASSING THE NO. 4 SIEVE BUT NO MORE THAN 5 PERCENT PASSING THE NO. 200 SIEVE, HAVING A SAND EQUIVALENT OF NO LESS THAN 35. THE MATERIAL SHALL BE SUITABLE FOR THE COMPACTION METHODS USED TO OBTAIN NO LESS THAN 90% OF MAXIMUM RELATIVE DENSITY.

L.- CONCRETE: CONCRETE REQUIRED FOR THRUST BLOCKS SHALL BE TRANSIT MIXED, PORTLAND CEMENT CONCRETE, HAVING A SLUMP AT TIME PLACEMENT NOT EXCEEDING 6 INCHES AND CONTAINING SUFFICIENT CEMENT TO PROVIDE A COMPRESSIVE STRENGTH OF NO LESS THAN 2000 PSI IN 28 DAYS.

- PIPELINE CONSTRUCTION - ALL WATER PIPE, FITTINGS AND APPURTENANCES CALLED FOR SHALL BE INSTALLED, DISINFECTED AND TESTED IN ACCORDANCE WITH THE FOLLOWING REFERENCED STANDARDS, THOSE OTHER STANDARDS THEREIN REFERENCED, THE WRITTEN RECOMMENDATIONS OF THE MANUFACTURER AND THESE SPECIAL PROVISIONS.


A.- INSTALLATION: AWWA C-600 AND C-605 EXCESS EARTH FROM EXCAVATIONS SHALL BE REMOVED FROM THE ROADWAY SECTION AND DISPOSED OF. TAPE SHALL BE PLACED IMMEDIATELY ABOVE THE PIPE ZONE BACKFILL. THE TEST PRESSURE FOR PIPE STRENGTH AND LEAKAGE SHALL BE NO LESS THAN 150 PSI.

B.- POLYETHYLENE WRAPPING: AWWA C-105. ALL FITTINGS AND APPURTENANCES INCLUDING BUT NOT LIMITED TO, VALVES, TEES, CROSSES, BENDS, TAPPED COUPLINGS, PIPE JOINT HARNESSSES, JOINT RESTRAINT DEVICES, AND JOINT ADAPTERS, SHALL BE ENCASED WITHIN A WRAPPING OF LOW-DENSITY, MINIMUM 10 MIL THICK, POLYETHYLENE SHEETING LOOSELY PLACED AND TAPED TO THE BODY OF THE CONNECTED PIPE(S).

C.- DISINFECTION: AWWA C-651. THE CONTRACTOR MAY EMPLOY ANY ONE OF THE DISINFECTION METHODS PROVIDED FOR, SUBJECT TO THE CITY ENGINEER'S REVIEW AND APPROVAL OF THE CONTRACTOR'S PROCEDURES, EQUIPMENT AND PROPOSED MEANS OF DISPOSING OF THE CHLORINATED WATER. THE DEVELOPER OR CONTRACTOR SHALL ARRANGE AND PAY FOR BACTERIOLOGICAL TESTING OF THE DISINFECTION EFFORTS. DISINFECTING SHALL CONTINUE UNTIL TESTING RESULTS ARE FOUND ACCEPTABLE TO THE CITY ENGINEER.

D.- COMPACTION TESTING: TESTING OF TRENCH BACKFILL FOR DENSITY SHALL BE NO LESS OFTEN THAN ONCE IN THE PIPE ZONE AND ONCE FOR EACH 24 INCHES OF DEPTH AT SPACING NOT TO EXCEED 150 FT. FAILING TEST SHALL BE RETESTED AFTER RECOMPACTION. RETESTING SHALL INCLUDE TWO ADDITIONAL TESTS, ONE EACH LOCATED 50 FT. BOTH WAYS FROM THE FAILING TEST LOCATION UNTIL ALL TESTS SHOW CONFORMING DENSITIES.

E.- VALVE BOXES: ALL VALVES SHALL BE INSTALLED WITH VALVE BOXES AS SHOWN OR CALLED FOR BY THE CONTRACT DRAWINGS.

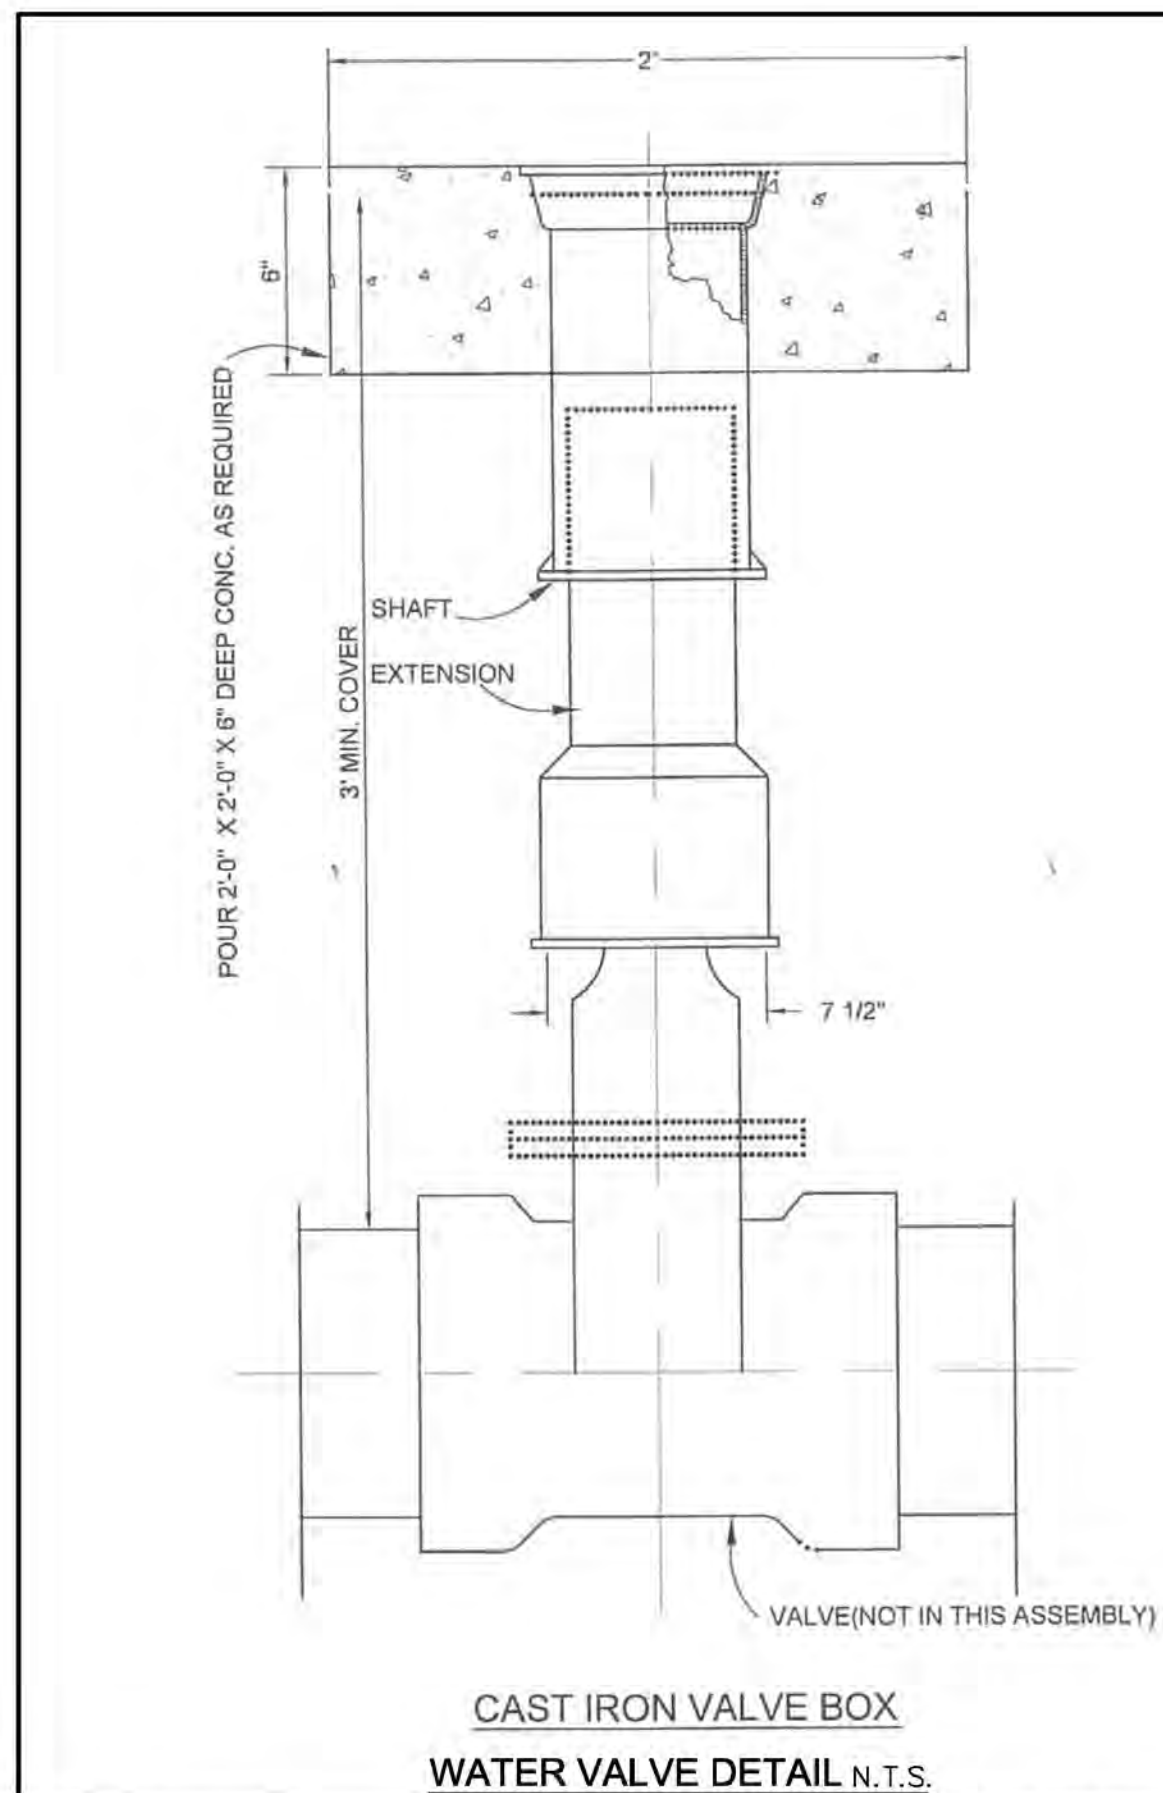

CAST IRON VALVE BOX  
WATER VALVE DETAIL N.T.S.


**WATER NOTES:**

- ALL WATER LINES INSTALLED SHALL BE HYDROSTATICALLY TESTED FOR LEAKAGE BASED ON THE "WATER PRESSURE TEST" SECTION OF THE MOST CURRENT VERSION OF THE "GREENBOOK: STANDARD SPECIFICATIONS FOR PUBLIC WORKS CONSTRUCTION".
- ALL WATER LINES INSTALLED SHALL BE HIGH-CHLORINE AND BAC-T TESTED, TEST RESULTS TO BE REVIEWED FOR APPROVAL BEFORE THE WATERLINE CAN BE ACTIVATED.
- DETECTABLE TAPE SHALL BE INSTALLED 1'-0" ABOVE THE WATERLINE.
- ALL COMPONENTS INSTALLED ALONG THE WATERLINE (I.E. FITTINGS, GATE VALVES, COUPLINGS, BURY ELS, ETC.) SHALL BE WRAPPED IN 8 MIL POLYETHYLENE PLASTIC BEFORE ANY BACKFILL IS COMPLETED.

**NOTES:**


BASE:  
CLASS II BASE  
COMPACTED TO  
95% OF MAX. DENS.  
PER ASTM D-1557

SUBGRADE:  
SUBGRADE COMPACTED  
TO 95% OF MAX. DENSIDAD.

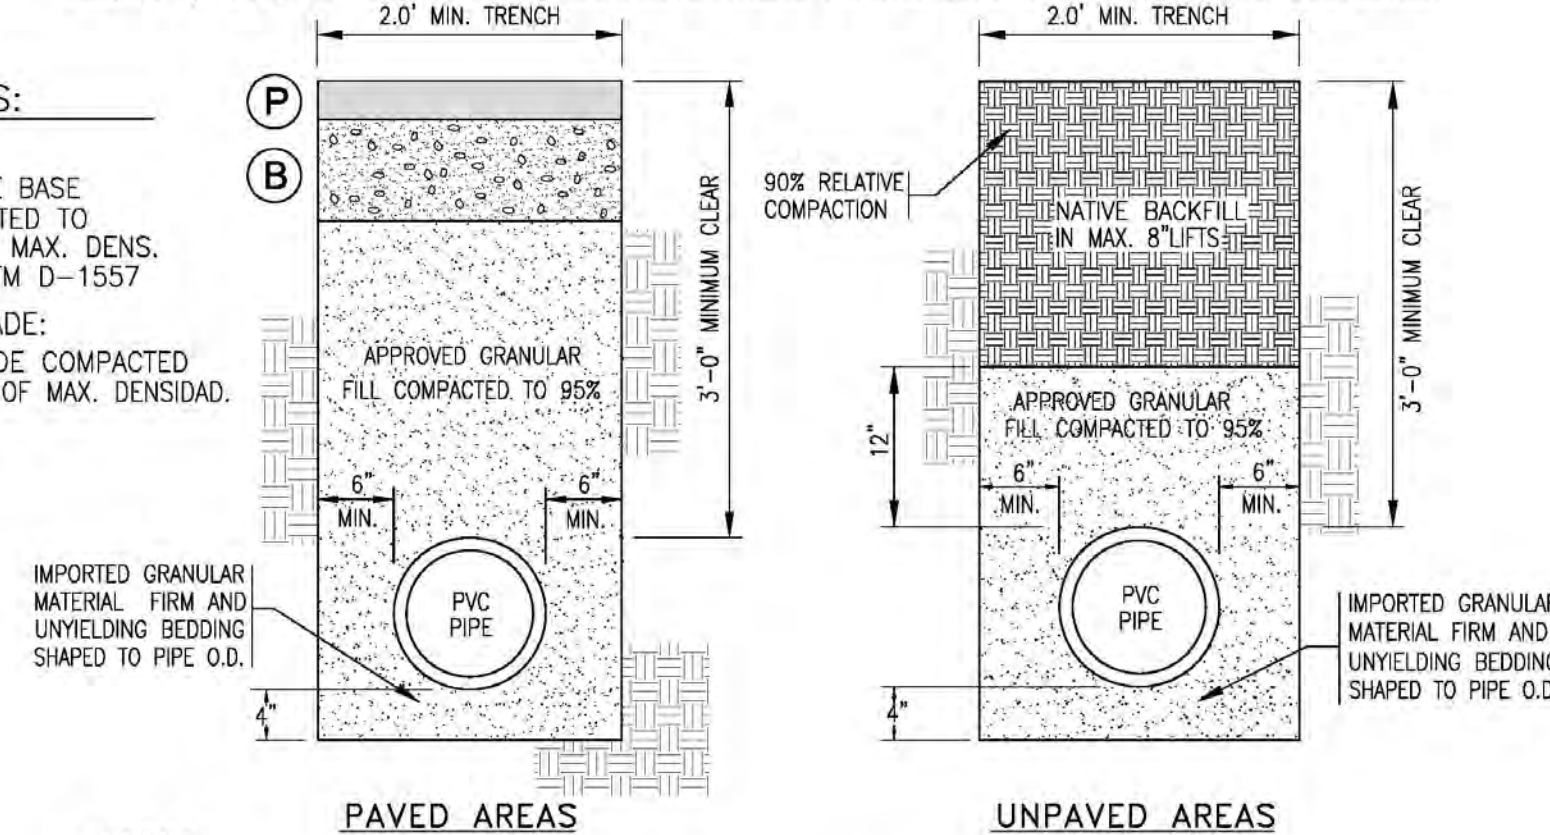


**NOTES:**

- ALL ANCHOR RODS SHALL BE GALVANIZED STEEL, 1/2" DIAMETER MINIMUM, WRAPPED AROUND PIPE
- ALL CONCRETE THRUST BLOCKS TO BEAR ON UNDISTURBED SOIL IN EACH DIRECTION OF THRUST

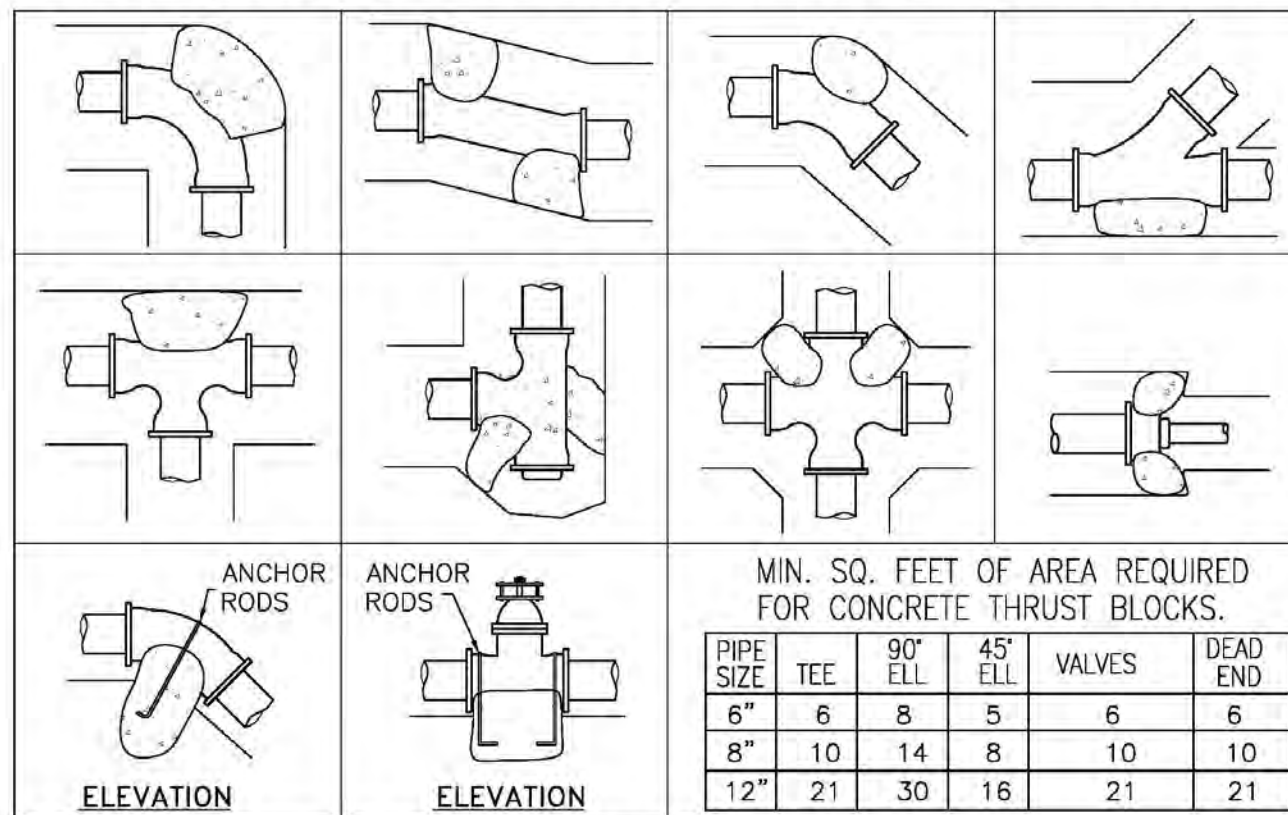


THRUST BLOCKS DETAILS  
WATER TRENCH DETAIL N.T.S. 2

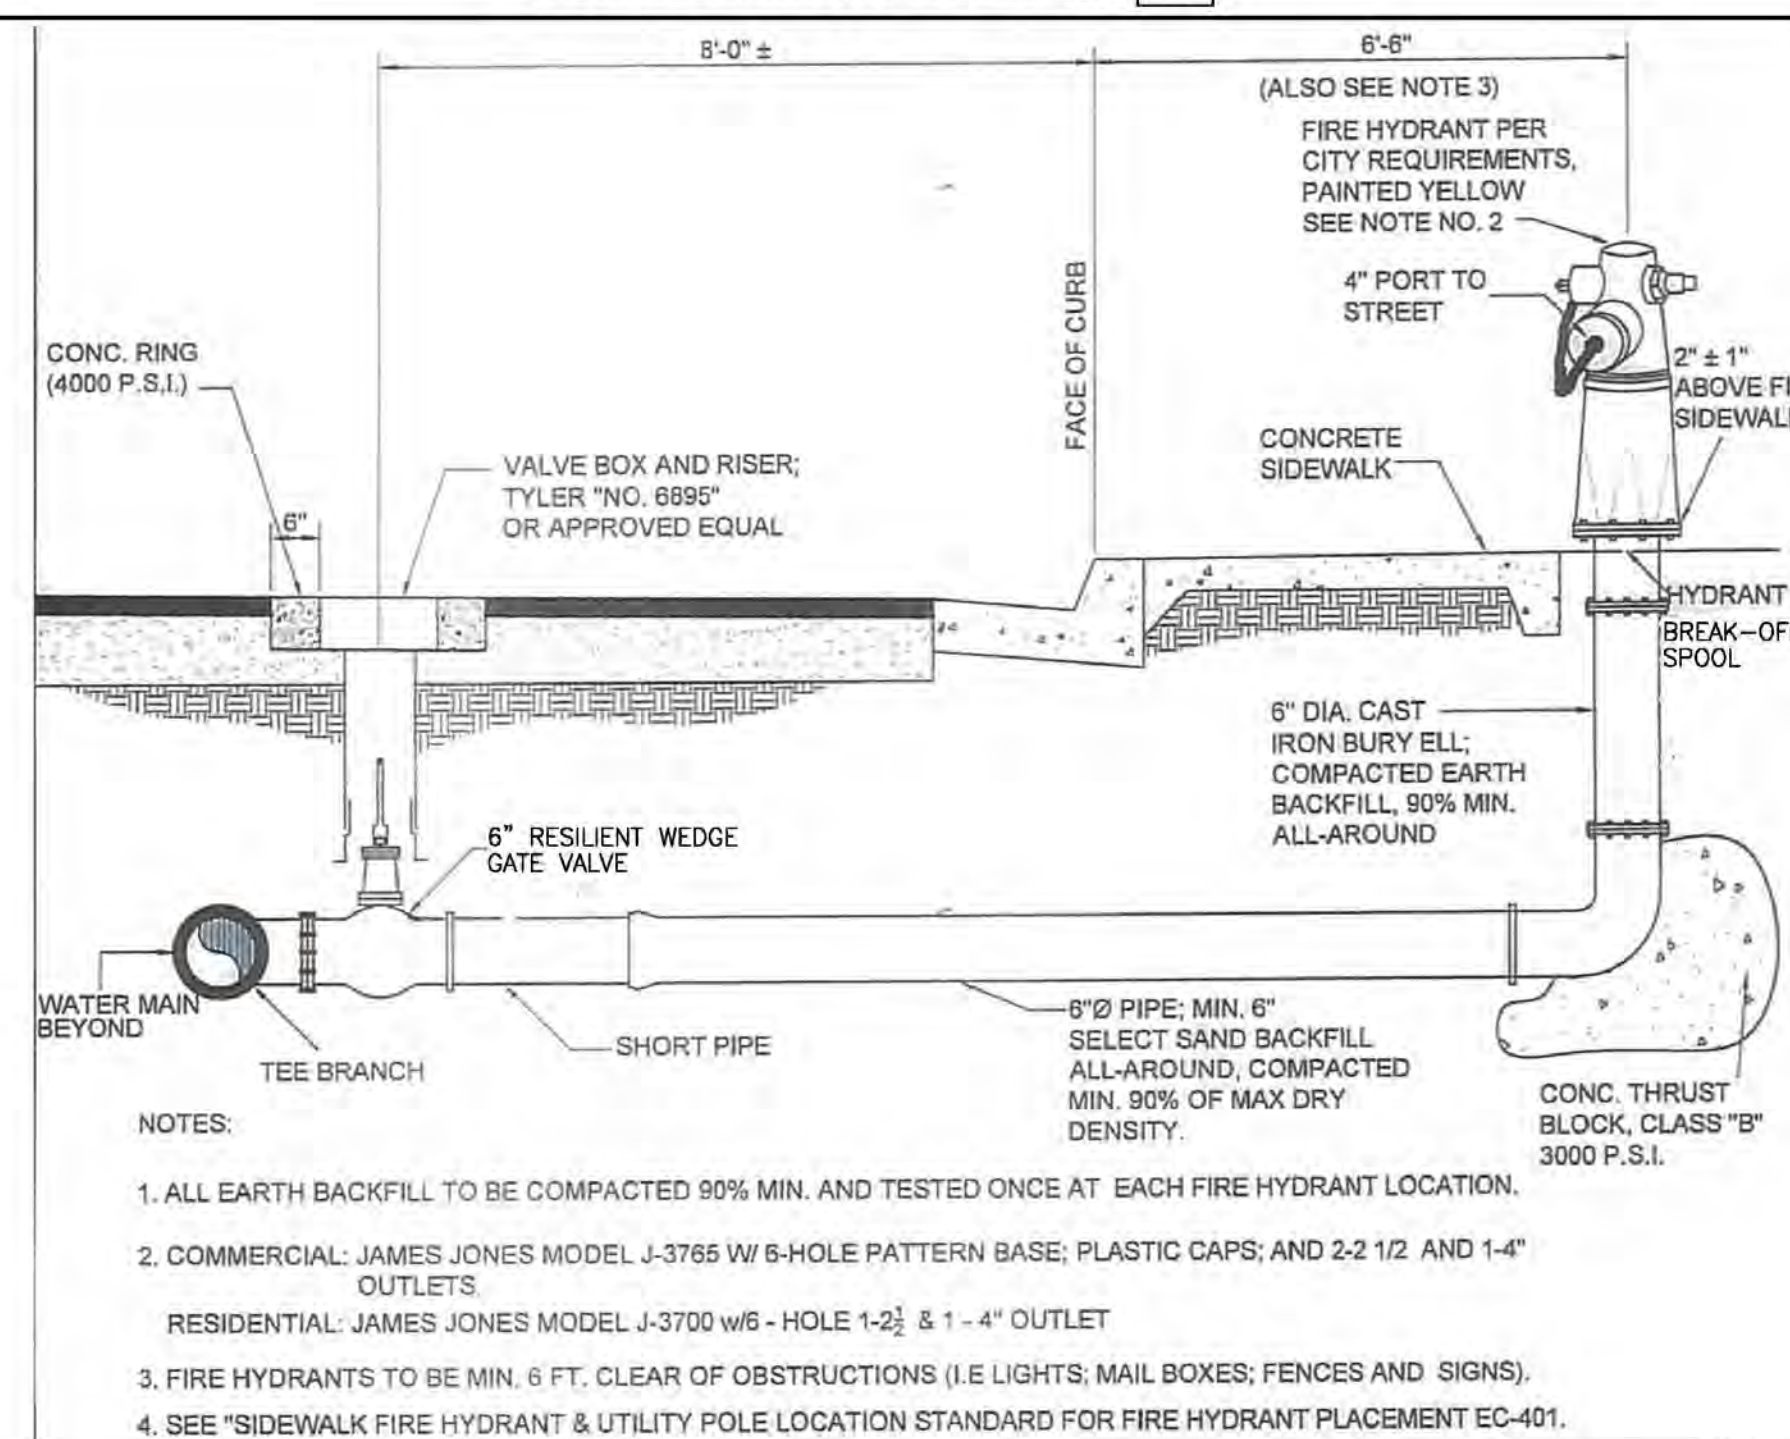

- NOTES:
- ALL EARTH BACKFILL TO BE COMPACTED 90% MIN. AND TESTED ONCE AT EACH FIRE HYDRANT LOCATION.
  - COMMERCIAL: JAMES JONES MODEL J-3765 W/ 6-HOLE PATTERN BASE; PLASTIC CAPS; AND 2-1/2 AND 1-4" OUTLETS.  
RESIDENTIAL: JAMES JONES MODEL J-3700 w/6 - HOLE 1-2" & 1-4" OUTLET
  - FIRE HYDRANTS TO BE MIN. 6 FT. CLEAR OF OBSTRUCTIONS (I.E. LIGHTS; MAIL BOXES; FENCES AND SIGNS).
  - SEE "SIDEWALK FIRE HYDRANT & UTILITY POLE LOCATION STANDARD FOR FIRE HYDRANT PLACEMENT EC-401.

FIRE HYDRANT DETAIL N.T.S. 3

**NOTE:**

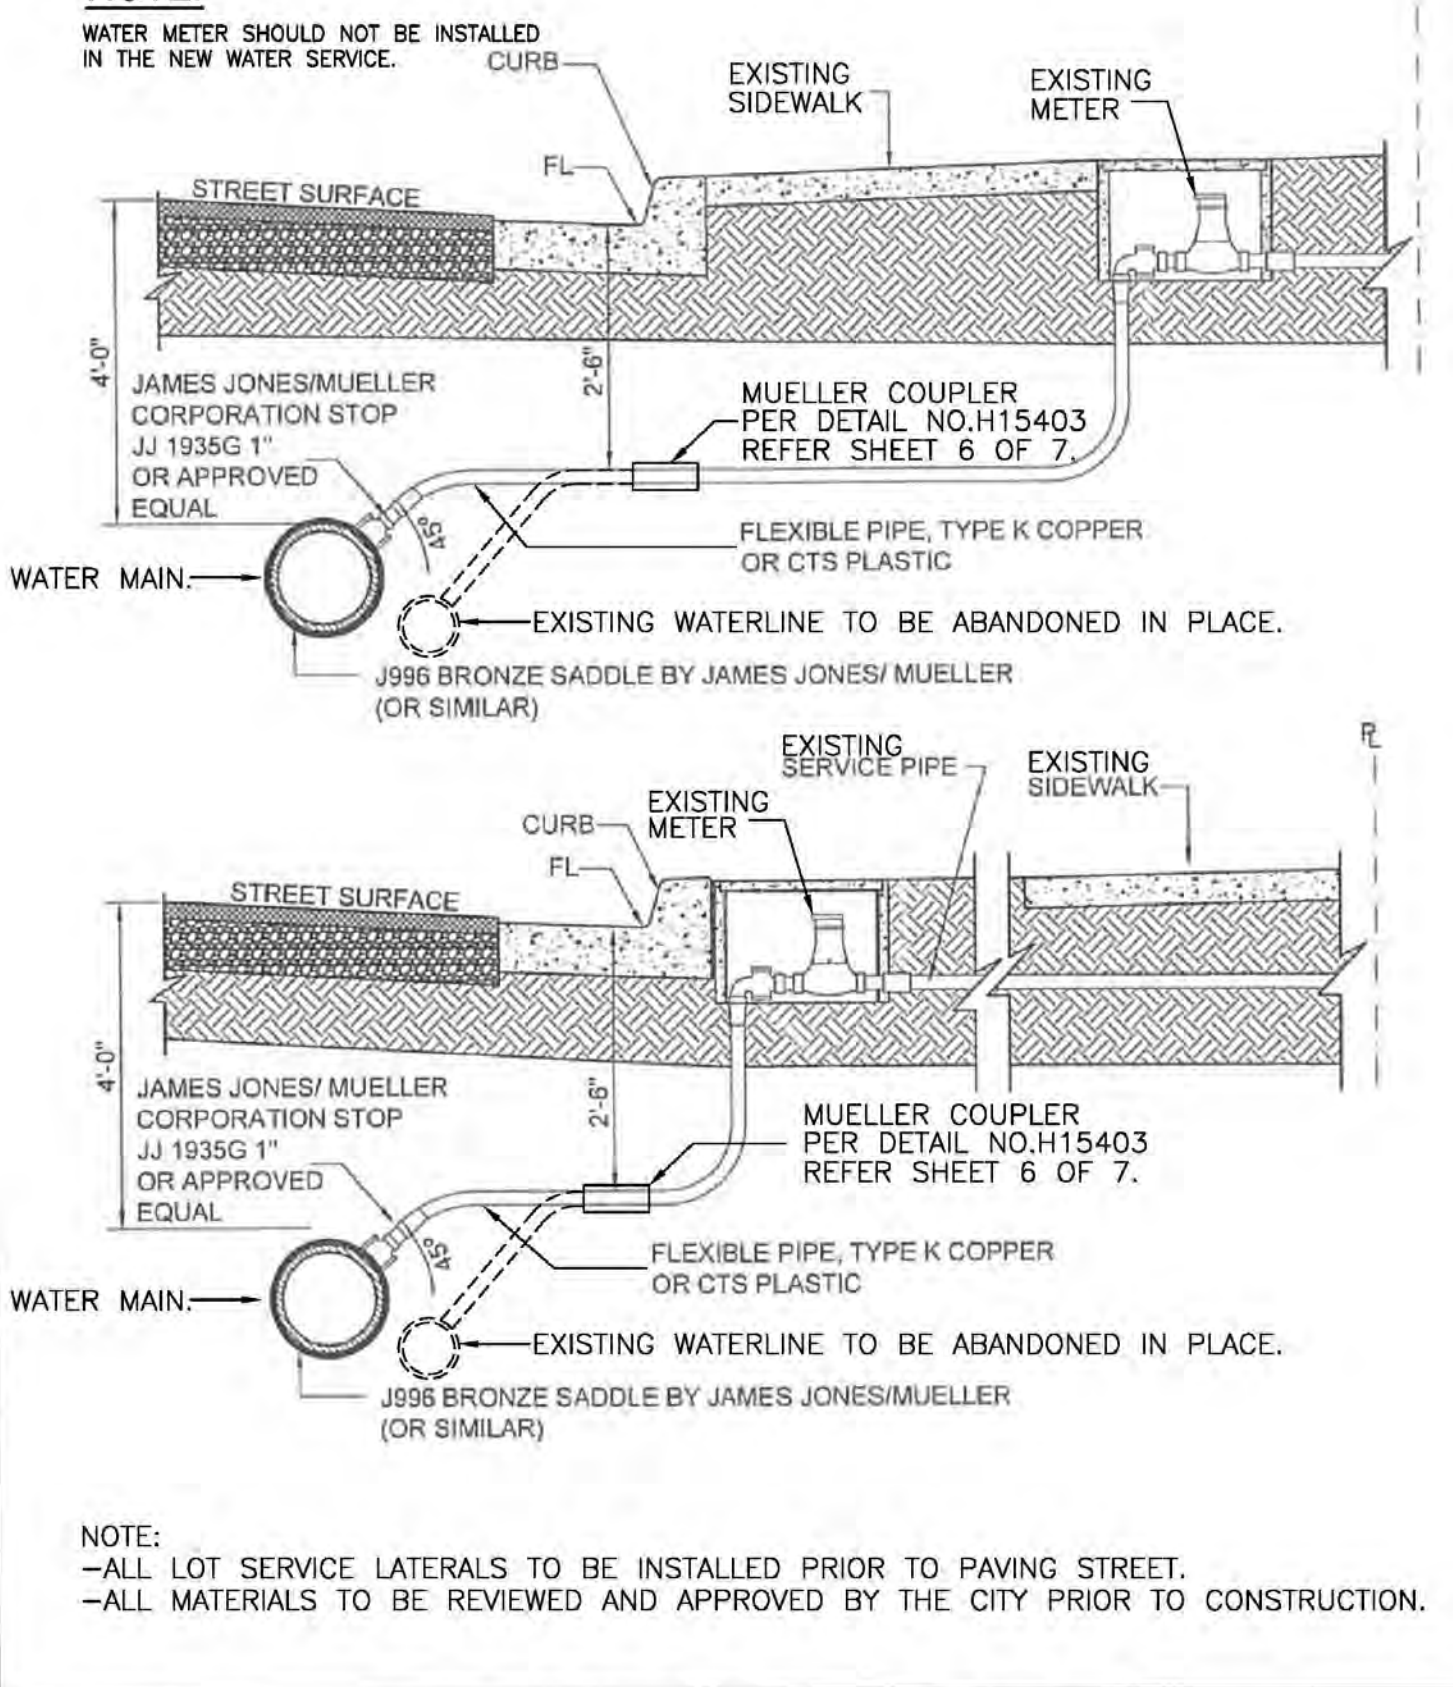

WATER SERVICE DETAIL N.T.S. 4

No.	QTY.	DESCRIPTION	MATERIAL
1	1	SPUD	CAST BRASS ASTM B62 ALLDY C83600
2	2	CONN. NUT	CAST BRASS ASTM B62 ALLDY C83600
3	2	CTS GSKT SUB	SBR D2000 - GSKT 410ss - BAND

SIZE	A
1/2	1.625
3/4	2.062
1	2.406
1x3/4	1.835
1-1/4	2.375
1-1/4x	2.154
1-1/2	3.312
1-1/2x	2.840
2	3.375

FILEPATH: PROJ-ENG\MUELLER\APPROVED\ENH5403

UNLESS OTHERWISE NOTED THIRD ANGLE PROJECTION

DATE: 5/25/02

BY: [Signature]

STK No. H-15403 STRAIGHT SERVICE FITTING

PER EST. NO. 00000 EST. FIN. WT. = 0.00000 lbs

PART NUMBER H15403

MUELLER COUPLER N.T.S.

CALL BEFORE UNDERGROUND SERVICE ALERT CALL: TOLL FREE 811 TWO WORKING DAYS BEFORE YOU DIG

APPROVED BY PUBLIC WORKS DIRECTOR CITY OF WESTMORLAND

BY: RAMIRO BARAJAS DATE: \_\_\_\_\_

ENGINEER OF RECORD

PLANS PREPARED UNDER THE SUPERVISION OF

BY: ROBERTO C. MARTINEZ DATE: \_\_\_\_\_

R.C.E. NO.: 74475



NO.	REVISION	DATE	BY

**BJ** ENGINEERING & SURVEYING, INC.

Phone (760) 363-3552 341 WEST CROWN CT, STE 100  
Fax (760) 353-3751 IMPERIAL, CA 92251

DWR-SCDRP- Water Distribution Piping Replacement

**CONSTRUCTION DETAILS AND SPECIFICATIONS**

IN THE CITY OF WESTMORLAND, CA DATE: 12/12/2024 BY: R.W.

CLIENT: CITY OF WESTMORLAND JOB NO.: 23-105

SHEET 6 OF 7

**STREET TECHNICAL SPECIFICATIONS**

**1. SUBBASE PREPARATION**  
 THE NATIVE MATERIAL BENEATH P.C.C. CONCRETE AND ASPHALT CONCRETE INFRASTRUCTURE INCLUDING BUT NOT LIMITED TO P.C.C. DRIVEWAY ENTRANCES, P.C.C. SIDEWALKS, P.C.C. RIBBON GUTTERS, P.C.C. VALLEY GUTTER, P.C.C. CROSS-GUTTER, P.C.C. BARRIER CURB, A.C. BARRIER CURB, P.C.C. CURB AND GUTTER, P.C.C. SIDEWALK, P.C.C. SPANDREL AREAS AND P.C.C. PAVEMENT SHALL BE EXCAVATED TO 4.00 FEET OF DESIGN SUBGRADE GRADE. THE DESIGN SUBGRADE SHALL BE FIELD VERIFIED AND APPROVED BY THE CITY ENGINEER PRIOR TO THE PLACEMENT OF GRANULAR SAND FILL, CRUSHER FINES OR CLASS 2 BASE. THE CITY ENGINEER SHALL DETERMINE THE NUMBER AND LOCATION OF TESTS TO CHECK FOR THE SUBGRADE GRADE ELEVATION COMPLIANCE. PRIOR TO THE CITY ENGINEER'S INSPECTION OF THE SUBGRADE GRADE THE CONTRACTOR SHALL ESTABLISH BLOTUP HUBS (STAKES SET TO DESIGN SUBGRADE) IF REQUIRED BY THE ENGINEER.

**2. SUBGRADE PREPARATION**  
 THE CLASS 2 BASE, SAND OR CRUSHER FINES BENEATH A.C. PAVEMENT AND CONCRETE INFRASTRUCTURE SHALL BE PLACED TO WITHIN ±0.02 FEET OF DESIGN SUBGRADE PRIOR TO THE PLACEMENT OF A.C. PAVEMENT OR P.C.C. CONCRETE. THE CITY ENGINEER SHALL FIELD VERIFY THE SUBGRADE ELEVATIONS IN THE FIELD PRIOR TO THE PLACEMENT OF CLASS 2 BASE, GRANULAR SAND MATERIAL OR CRUSHER FINES. PLACEMENT OF P.C.C. CONCRETE OR A.C. PAVEMENT SHALL NOT BE ALLOWED UNTIL THE ENGINEER HAS APPROVED THE SUBGRADE DESIGN GRADE.

**3.0 SAND**  
 CLEAN GRANULAR SAND FREE OF CLAY, SHALE AND DELETERIOUS MATERIAL SHALL BE DELIVERED TO THE SITE AND PLACED AS NOTED ON THE PLANS. SAND SHALL BE COMPACTED TO 90 PERCENT OF MAXIMUM DENSITY AT OPTIMUM WATER CONTENT PER ASTM D-1557 UNLESS OTHERWISE NOTED ON THE PLANS. THE MATERIAL SHALL CONFORM TO THE SAND EQUIVALENT OF 30 OR GREATER. THE MAXIMUM AMOUNT OF MATERIAL PASSING THE NUMBER 200 SIEVE SHALL BE 7 PERCENT. THE SAND SHALL CONFORM TO THE FOLLOWING GRADATION PERCENTAGES:

SIEVE SIZE	PERCENT PASSING
3/8"	100
NO. 4	98-99
NO. 8	85-90
NO. 10	75-80
NO. 18	60-50
NO. 30	40-35
NO. 40	38-29
NO. 100	28-19
NO. 200	7-0

THE CONTRACTOR SHALL SUPPLY A FIVE GALLON SAMPLE OF SAND MATERIAL TO THE MATERIAL TESTING LABORATORY WITHIN FOUR (4) DAYS AFTER THE NOTICE TO PROCEED IS ISSUED. THE GRADATION, SAND EQUIVALENT AND MAXIMUM DENSITY OF THE SAND MATERIAL SHALL BE DETERMINED. THE TEST RESULTS SHALL BE FORWARDED TO THE ENGINEER. THE COST OF TESTING SHALL BE INCURRED BY THE CONTRACTOR. THE GRADATION OF THE GRANULAR SAND SHALL BE DETERMINED AND THE TEST RESULTS FORWARDED TO THE CITY ENGINEER PRIOR TO THE DELIVERY OF THE GRANULAR SAND MATERIAL TO THE CONSTRUCTION SITE. PRIOR TO THE PLACEMENT OF SAND THE NATIVE SUBBASE GRADE SHALL BE CHECKED AND APPROVED BY THE CITY ENGINEER.

CRUSHER FINES SHALL BE ALLOWED TO BE UTILIZED IN LIEU OF SAND IF APPROVED BY THE CITY ENGINEER.

**4.0 CRUSHER FINES**  
 CRUSHER FINES SHALL CONSIST OF DECOMPOSED GRANITE INDIGENOUS TO THE IMPERIAL VALLEY. CRUSHER FINES UTILIZED FOR THIS PROJECT SHALL CONFORM TO THE FOLLOWING GRADATION REQUIREMENTS:

SIEVE SIZE	PERCENT PASSING
5/8"	100
NO. 4	80-100
NO. 8	50-85
NO. 30	30-50
NO. 200	4-15

THE SAND EQUIVALENT SHALL BE 20 OR GREATER.

**5.0 CLASS 2 BASE**  
 THE CLASS 2 BASE MATERIAL SHALL CONFORM TO CALTRANS SECTION 26, LATEST EDITION, FOR 25MM MAXIMUM BASE MATERIAL. THE GRADATION REQUIREMENTS ARE AS FOLLOWS:

SIZE	PERCENT PASSING
1 1/2" 25.04MM	100
3/4 19.00MM	87-100
#4 4.75MM	30-65
#30/600MM	5-35
#200/75.00MM	0-12

THE SAND EQUIVALENT SHALL BE 25 OR GREATER. AN ANGULAR AGGREGATE IS TO BE USED. CLASS 2 BASE MATERIAL SHALL BE COMPACTED TO 95 PERCENT OF MAXIMUM DENSITY ACCORDING TO ASTM D-1557, UNLESS OTHERWISE NOTED ON THE PLANS OR DETAILS. THE TOLERANCE FOR THE CLASS 2 BASE BETWEEN DESIGN SUBGRADE ELEVATION AND ACTUAL SUBGRADE ELEVATION AS CONSTRUCTED IN THE FIELD SHALL BE PLUS OR MINUS 0.02 FEET AS REFERENCED FROM THE DESIGN SUBGRADE. PRIOR TO THE PLACEMENT OF CLASS 2 BASE THE NATIVE SUBBASE GRADE SHALL BE CHECKED AND APPROVED BY THE CITY ENGINEER. THE NATIVE SUBBASE GRADE SHALL BE WITHIN PLUS OR MINUS 0.05 FEET OF NATIVE SUBBASE DESIGN GRADE PRIOR TO THE PLACEMENT OF CLASS 2 BASE.

THE CONTRACTOR SHALL SUPPLY A FIVE GALLON SAMPLE OF THE CLASS 2 BASE TO THE MATERIAL TESTING LABORATORY WITHIN FOUR (4) DAYS OF THE NOTICE TO PROCEED. THE MATERIAL SHALL BE DELIVERED TO THE TESTING LABORATORY TO DETERMINE THE MAXIMUM DENSITY, GRADATION, R-VALUE, SAND EQUIVALENT AND DURABILITY INDEX. A COPY OF THE TEST RESULTS SHALL BE FORWARDED TO THE CITY ENGINEER BY THE GEOTECHNICAL CONSULTANT FOR REVIEW. THE GRADATION OF THE CLASS 2 BASE SHALL BE DETERMINED AND THE TEST RESULTS FORWARDED TO THE CITY ENGINEER FOR APPROVAL PRIOR TO THE DELIVERY OF THE CLASS 2 BASE MATERIAL TO THE CONSTRUCTION SITE. CLASS 2 BASE UTILIZING RECYCLED MATERIALS SHALL NOT BE ALLOWED.

**6.0 P.C.C. CONCRETE**

P.C.C. CONCRETE, UTILIZED FOR BUT NOT LIMITED TO, CURB AND GUTTER, BARRIER CURB, SPANDRELS, CROSS-GUTTER, VALLEY GUTTER, RIBBON GUTTERS, RESIDENTIAL AND COMMERCIAL DRIVEWAYS, SIDEWALKS AND ALL OTHER CONCRETE INFRASTRUCTURE SHALL CONTAIN A MINIMUM OF 6 % SACKS OF CEMENT PER YARD AND ATTAIN 4,500 P.S.I. COMPRESSIVE STRENGTH AFTER 28 DAYS CURING UNLESS STATED OTHERWISE ON THE PLANS. A CONCRETE MIX DESIGN IS TO BE SUBMITTED TO THE ENGINEER WITHIN FIVE (5) DAYS AFTER THE ISSUANCE OF THE NOTICE TO PROCEED. NEW FORMWORK SHALL BE UTILIZED IN THE CONSTRUCTION OF EVERY CONCRETE FACILITY. THE FORMWORK SHALL BE TRUE TO LINE AND GRADE. THE VERTICAL FLOWLINE ELEVATION TOLERANCE SHALL BE +/- 0.02 FEET FOR DESIGN GRADE FOR SLOPES OF 1.0% OR GREATER, +/- 0.01 FOR DESIGN GRADE FOR SLOPES LESS THAN 1.0%. THE ENGINEER SHALL CHECK THE FORMWORK FOR LINE AND GRADE PRIOR TO THE PLACEMENT OF CONCRETE. CONCRETE "CURB MACHINES" SHALL NOT BE ALLOWED FOR CURB AND GUTTER AND RIBBON GUTTERS DESIGNED AT A SLOPE OF 1 PERCENT OR LESS. THE SUBCONTRACTOR SHALL NOTIFY THE ENGINEER 72 HOURS PRIOR TO THE REQUIRED INSPECTION. EXPOSED SURFACES OF CONCRETE AREAS SHALL RECEIVE A DOUBLE TROWEL FINISH. WEAKENED PLANE JOINTS SHALL BE PLACED EVERY 64 LINEAL FEET FOR RIBBON GUTTER, CROSS GUTTER AND VALLEY GUTTER CONSTRUCTION UNLESS OTHERWISE ILLUSTRATED ON THE STANDARD PLANS. EXPANSION JOINTS SHALL BE PLACED EVERY 64 FEET ALONG CURB AND GUTTER, BARRIER CURB, VALLEY GUTTER AND SIDEWALK CONSTRUCTION UNLESS OTHERWISE ILLUSTRATED ON THE STANDARD PLANS. INSTALLATION OF CURB AND GUTTER, VALLEY GUTTER AND CROSS-GUTTERS SHALL BEGIN AT THE LOWEST ELEVATION AND PROCEED UPHILL. A TOTAL OF ONE (1) SET OF CYLINDERS AND ONE (1) SLUMP TEST SHALL BE REQUIRED FOR EVERY 50 CUBIC YARDS OF CONCRETE, EXCEPT THAT A MINIMUM OF ONE (1) SET OF CYLINDERS AND SLUMP TEST SHALL BE REQUIRED EACH DAY TWENTY (20) OR MORE YARDS OF CONCRETE ARE PLACED AT A PROJECT SITE. THE MAXIMUM ALLOWABLE SLUMP SHALL BE 4 INCHES. A SLUMP TEST SHALL BE COMPOSED OF THREE (3) CYLINDERS. THE FIRST CYLINDER OF A SET SHALL BE TESTED AFTER SEVEN (7) DAYS CURING. THE SECOND CYLINDER OF A SET SHALL BE TESTED AFTER 28 DAYS CURING. THE THIRD CYLINDER SHALL BE HELD IN STORAGE AND TESTED IF DIRECTED BY THE CITY ENGINEER. THE TEST RESULTS WILL BE FORWARDED TO THE CITY ENGINEER FOR REVIEW. THE CITY ENGINEER SHALL RECEIVE A CONCRETE VENDOR SLIP FOR EACH TRUCK LOAD OF CONCRETE DELIVERED TO THE PROJECT SITE.

PRIOR TO THE PLACEMENT OF CONCRETE, THE SUBGRADE DEPTH SHALL BE INSPECTED TO INSURE THAT THE FULL DEPTH OF THE CLASS 2 BASE IS ATTAINED. THE EXCESS FILL MATERIAL SHALL BE REMOVED AS REQUIRED BY THE CITY ENGINEER. THE FORMBOARDS SHALL BE CHECKED FOR THE PROPER ELEVATION. COMPACTION TESTS ON THE SUBGRADE SHALL HAVE ACHIEVED THE DENSITY REQUIREMENTS SPECIFIED. THE ENGINEER SHALL THEN ALLOW THE PLACEMENT OF CONCRETE.

THE CONCRETE SHALL BE SCREPPED AND FLOATED. ALL EDGES SHALL BE STRUCK WITH A CONCRETE EDGE. WEAKENED PLANE JOINTS SHALL BE ESTABLISHED AT RIGHT ANGLES TO THE SIDEWALK EDGE AS ILLUSTRATED ON THE STANDARD DRAWINGS. THE WEAKENED PLANE JOINTS SHALL BE 3/8 INCH IN WIDTH AND 3/4 INCH IN DEPTH. EXPANSION JOINTS CONSISTING OF 1/2 INCH THICK CELOTEX MATERIAL SHALL BE PLACED ACROSS THE FULL SECTION OF THE P.C.C. SIDEWALK EVERY 64 LINEAL FEET, OR AS REQUIRED BY THE STANDARD PLANS. AFTER THE CONCRETE SURFACE HAS BEEN FLOATED AND CURED ADEQUATELY, IT SHALL RECEIVE A DOUBLE TROWEL FINISH. THE TROWELING SHALL BE ACCOMPLISHED BY HAND WITH A STEEL TROWEL. THE SURFACE OF THE CONCRETE SHALL RECEIVE A LIGHT BROOM FINISH AFTER THE SURFACE IS DOUBLE TROWELED. THE SURFACE OF THE CONCRETE SHALL BE SMOOTH AND TRUE TO GRADE. TOLERANCE FOR THE CONCRETE SURFACE SHALL BE 1/8 INCH IN 10 LINEAL FEET WITH MAXIMUM HIGH AND LOW VARIANCE NOT OCCURRING IN LESS THAN 20 FEET. THE CONTRACTOR SHALL APPLY A CURING COMPOUND TO THE CONCRETE.

THE CONCRETE SURFACES SHALL BE CLEANED OF ALL DIRT AND RESIDUE PRIOR TO THE PLACEMENT OF THE CONCRETE SEALER. CONCRETE SHALL NOT BE PLACED AFTER 10:00 A.M. ON FRIDAYS.

**7.0 BITUMINOUS PAVEMENT**

THE BITUMINOUS ASPHALT CONCRETE SHALL CONSIST OF MINERAL AGGREGATE, UNIFORMLY MIXED WITH BITUMINOUS MATERIAL AT A CENTRAL PLANT. AGGREGATE BASE SHALL 19MM(3/4 INCH) MAXIMUM, MEDIUM. THE ASPHALT CONCRETE SHALL CONFORM WITH THE FOLLOWING PERCENTAGES:

LIMITS OF PROPOSED	SIEVE SIZE	PERCENT PASSING	GRADATION - X
	1 1/2" 25.00MM	100	-----
	3/4 19.00MM	90 - 100	-----
	3/8 19.50MM	60 - 85	-----
	#4/4.75MM X +/- 8	49 - 54	-----
	#20/2.50MM X +/- 8	36 - 40	-----
	#30/0.600MM X +/- 8	18 - 21	-----
	#200/0.075MM	0 - 11	-----

IN THE TABLE ABOVE, "X" IS THE GRADATION WHICH THE CONTRACTOR PROPOSES TO FURNISH FOR SPECIFIC SIEVE.

ASPHALT BINDER SHALL BE IN ACCORDANCE WITH THE APPROVED A.C. MIX DESIGN.

THE ASPHALT CONCRETE SHALL BE TYPE "A" OR "B" AS SET FORTH IN THE STATE OF CALIFORNIA, DEPARTMENT OF TRANSPORTATION, STANDARD SPECIFICATIONS, SECTION 39, LATEST EDITION, UNLESS OTHERWISE SPECIFIED WITHIN THESE SPECIFICATIONS. THE ASPHALT CONCRETE SHALL BE APPLIED WITH A VIBRATORY MACHINE. THE GRADE OF ALL ASPHALT BITUMEN SHALL BE AR (AGED RESIDUE) 4,000 OR AR 8000 AS APPROVED BY THE CITY ENGINEER. THE MINIMUM BITUMEN SHALL BE IN ACCORDANCE WITH THE APPROVED MIX DESIGN. THE ASPHALT CONCRETE SHALL BE COMPACTED TO 95 PERCENT OF MAXIMUM DENSITY PER ASTM D-1559. THE TEMPERATURE OF THE ASPHALT WHEN DELIVERED TO THE APPLICATION SITE SHALL RANGE BETWEEN 285 DEGREES F AND 359 DEGREES F. THE FINISHED SURFACE SHALL BE WITHIN +/- 0.02 FEET OF FINISH DESIGN GRADE WITH MAXIMUM HIGH AND LOW VARIANCE OCCURRING IN A MAXIMUM OF 10 HORIZONTAL FEET.

ROLLERS OF THE VIBRATORY, STEEL WHEEL, OR PNEUMATIC-TIRED TYPE MAY BE USED. THEY SHALL BE IN GOOD CONDITION, CAPABLE OF OPERATING AT SLOW SPEEDS TO AVOID DISPLACEMENT OF THE BITUMINOUS MIXTURE. THE NUMBER, TYPE, AND WEIGHT OF ROLLERS SHALL BE SUFFICIENT TO COMPACT THE MIXTURE TO THE REQUIRED DENSITY WHILE IT IS STILL IN A WORKABLE CONDITION. THE USE OF EQUIPMENT WHICH CAUSES EXCESSIVE CRUSHING OF THE AGGREGATE WILL NOT BE PERMITTED.

AFTER SPREADING, THE MIXTURE SHALL BE THOROUGHLY AND UNIFORMLY COMPACTED BY ROLLING. THE SURFACE SHALL BE ROLLED WHEN THE MIXTURE HAS ATTAINED SUFFICIENT STABILITY SO THAT THE ROLLING DOES NOT CAUSE UNDEE DISPLACEMENT, CRACKING OR SHOWING. THE SEQUENCE OF ROLLING OPERATIONS AND THE TYPE OF ROLLERS USED SHALL BE AT THE DISCRETION OF THE CONTRACTOR.

THE SPEED OF THE ROLLER SHALL, AT ALL TIMES, BE SUFFICIENTLY SLOW TO AVOID DISPLACEMENT OF THE HOT MIXTURE. ANY DISPLACEMENT OCCURRING AS A RESULT OF REVERSING THE DIRECTION OF THE ROLLER OR FROM ANY OTHER CAUSE, SHALL BE CORRECTED AT ONCE.

ROLLING SHALL CONTINUE UNTIL THE ROLLER MARKS ARE ELIMINATED, THE SURFACE IS OF UNIFORM TEXTURE AND TRUE TO GRADE AND CROSS SECTION AND THE REQUIRED FIELD DENSITY IS OBTAINED.

TO PREVENT ADHESION OF THE MIXTURE TO THE ROLLER, THE WHEELS SHALL BE KEPT PROPERLY MOISTENED, BUT EXCESSIVE WATER WILL NOT BE PERMITTED.

IN AREAS NOT ACCESSIBLE TO THE ROLLER, THE MIXTURE SHALL BE THOROUGHLY COMPACTED WITH HOT HAND TAMPERS.


ANY MIXTURES THAT BECOME LOOSE AND BROKEN, MIXED WITH DIRT, OR IN ANYWAY DEFECTIVE, SHALL BE REMOVED AND REPLACED WITH FRESH HOT MIXTURE AND IMMEDIATELY COMPACTED TO CONFORM TO THE SURROUNDING AREA. THIS WORK SHALL BE DONE AT THE CONTRACTOR'S EXPENSE.

THE CONTRACTOR SHALL PAY FOR ALL COSTS ASSOCIATED WITH THE PREPARATION OF THE MARSHALL MIX DESIGN, COMPACTION TESTS AND EXTRACTION/GRADATION TESTS REQUIRED FOR THIS PROJECT. THE CONTRACTOR SHALL INCUR ALL COSTS RELATIVE TO THE PREPARATION OF THE MARSHALL MIX DESIGN AND GEOTECHNICAL TESTING RELATIVE TO THIS PROJECT.

A SAMPLE OF THE BITUMINOUS MIX WILL BE OBTAINED EACH MORNING PAVEMENT OPERATIONS ARE OCCURRING. THE SAMPLE SHALL BE OBTAINED BY THE GEOTECHNICAL TESTING CONSULTANT. THE MAXIMUM DENSITY OF THE SAMPLE SHALL BE DETERMINED. THE RESULTS OF THE TEST WILL BE USED TO BASE THE FIELD DENSITY TESTS AGAINST AN EXTRACTION FROM THE SAMPLE. SHALL BE TAKEN TO DETERMINE THE PERCENTAGE OF BITUMEN IN THE MIX. THE GRADATION OF THE SAMPLE SHALL ALSO BE OBTAINED. DENSITY TESTS WILL BE TAKEN DURING THE ROLLING OPERATION. THE PAVEMENT SHALL CONTINUE TO BE ROLLED UNTIL THE DESIRED DENSITY IS OBTAINED. THE COSTS ASSOCIATED WITH THE TESTING SHALL BE BORNE BY THE PROVIDER TWO (2) SETS OF TEST REPORTS TO THE CITY ENGINEER. A FIELD TECHNICIAN PROVIDED BY THE GEOTECHNICAL TESTING CONSULTANT SHALL BE AVAILABLE DURING THE ASPHALT PLACEMENT TO CONTINUOUSLY MONITOR THE DENSITY OF THE ASPHALT.

**8. WATER VALVE FRAMES AND COVERS**

ALL WATER VALVE BOXES AND LIDS, GAS VALVE BOXES AND LIDS, AND OTHER SIMILAR EXISTING UTILITIES SHALL BE RAISED TO THE GRADE OF THE FINISHED PAVEMENT SURFACE. BY THE CONTRACTOR. WATER VALVE LIDS AND SIMILAR UTILITY COVERS SHALL BE LOWERED A MINIMUM OF 3 INCHES BELOW THE DESIGN PAVEMENT SURFACE PRIOR TO THE INSTALLATION OF A.C. PAVEMENT. WATER VALVE LIDS SHALL BE RAISED AFTER PAVING OPERATIONS HAVE OCCURRED. WATER AND GAS VALVE EXTENSION RISERS AND COVERS SHALL BE RAISED 3/8 INCHES BELOW THE PAVEMENT GRADE AFTER PAVING OPERATIONS ARE COMPLETE.

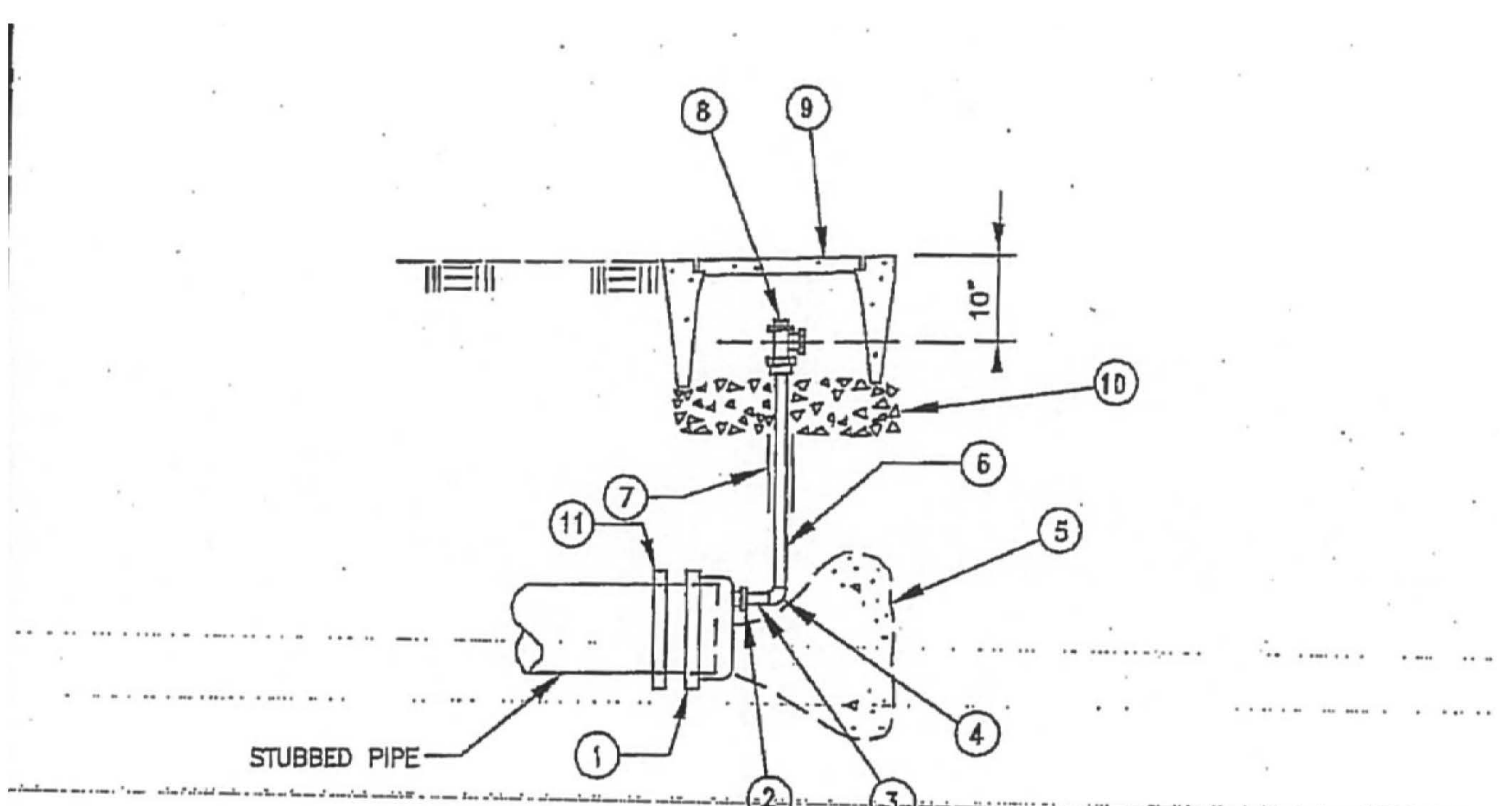

**CONSTRUCTION NOTES**

- | ITEM # | SIZE & DESCRIPTION                                       |
|--------|--|
| 1.     | SET TOP OF METER BOX FLUSH WITH SIDEWALK.                |
| 2.     | SPLICES OF COPPER TUBING SHALL NOT BE ALLOWED.           |
| 3.     | POLY-SLEEVE COLORS REQUIRED BLUE = POTABLE WATER SERVICE |
| 4.     | METER BOX TO BE PAINTED OSHA SAFETY YELLOW - 2 COATS.    |
| 5.     | INSTALL THRUST BLOCK PER TEMPORARY THRUST BLOCK DRAWING. |
| 6.     | IF BENDS ARE REQUIRED IN COPPER, USE 12" MINIMUM RADIUS. |
| 7.     | SEE APPROVED MATERIAL LIST.                              |
| 8.     | DO NOT PLACE CONCRETE ON COPPER OR PIPE.                 |
| 1.     | TAPPED CAP, DUCTILE IRON WITH OFFSET 2" OPENING, I       |
| 2.     | 2" x 1" NYLON BUSHING                                    |
| 3.     | 1" SWEAT x M.I.P., ADAPTOR                               |
| 3.     | 1" COMPRESSION x M.I.P.                                  |
| 4.     | 1" COPPER ELL 90°  |
| 4.     | 1" ELL 90° COMPRESSION                                   |
| 5.     | THRUST BLOCK   |
| 6.     | 1" COPPER TUBING K SOFT                                  |
| 7.     | 1" POLY-SLEEVE - 6 MIL-BLUE                              |
| 8.     | 1" METER STOP, ANGLE-COMPRESSION OR FLARE                |
| 9.     | METER BOX BROOKE PRODUCTS NO.37 OR EQUAL.                |
| 10.    | 6" BASE OF 3/8" ROCK                                     |
| 11.    | JOINT RESTRAINT DEVICE                                   |

STUB-OUT BLOWOFF N.T.S. **1**

**WATER TECHNICAL SPECIFICATIONS**

**1.1 PIPE INSTALLATION**

THIS SECTION COVERS FURNISHING ALL LABOR, SUPERVISION, MATERIALS AND EQUIPMENT AND PERFORMING ALL OPERATIONS NECESSARY TO FURNISH AND INSTALL THE PIPING, FITTINGS, AND VALVES. ALL PIPE, FITTINGS, VALVES AND ACCESSORIES FURNISHED BY THE CONTRACTOR SHALL BE NEW MATERIAL, FREE FROM RUST OR CORROSION. ALL PIPING, VALVES AND FITTINGS SHALL BE CLEANED ON THE INSIDE WHEN INSTALLED AND THE CONTRACTOR SHALL TAKE ALL NECESSARY PRECAUTIONS TO INSURE THAT THE LINES ARE KEPT FREE OF ANY FOREIGN MATTER AND DIRT UNTIL THE WORK IS COMPLETE. ALL PIPE SHALL BE CAREFULLY PLACED AND SUPPORTED AT THE PROPER LINES AND GRADES, AS SHOWN ON THE DRAWINGS. PIPING RINGS SHOWN ON THE DRAWINGS SHALL BE FOLLOWED AS CLOSELY AS POSSIBLE EXCEPT FOR MINOR ADJUSTMENTS TO ACCOMMODATE THE ACTUAL FIELD CONDITIONS. ALL RELOCATIONS ARE REQUIRED. THEY SHALL BE APPROVED BY THE CITY ENGINEER. THE BEDDING SHALL BE DEFINED AS THAT MATERIAL SUPPORTING, SURROUNDING AND EXTENDING TO ONE FOOT ABOVE THE TOP OF THE PIPE. IF SOFT, SPONGY UNSTABLE OR SIMILAR OTHER MATERIAL IS ENCOUNTERED UPON WHICH THE BEDDING MATERIAL OR PIPE IS TO BE PLACED, THIS UNSUITABLE MATERIAL SHALL BE REMOVED TO A DEPTH ORDERED BY THE CITY ENGINEER AND REPLACED WITH BEDDING MATERIAL SUITABLY DENSIFIED. BEDDING MATERIAL SHALL FIRST BE PLACED SO THAT THE PIPE IS SUPPORTED FOR THE FULL LENGTH OF THE BARREL WITH FULL BEARING ON THE BOTTOM SEGMENT OF THE PIPE. HUNCHING OF THE PIPE SHALL NOT BE ALLOWED. THE REMAINDER OF THE BEDDING SHALL THEN BE PLACED, EXCEPT WHERE OTHERWISE SPECIFIED OR ILLUSTRATED ON THE PLANS. BEDDING MATERIAL SHALL BE GRANULAR SAND MATERIAL. IT SHALL BE CAREFULLY INSPECTED IN THE FIELD BEFORE AND AFTER LAYING. IF ANY CAUSE FOR REJECTION IS DISCOVERED IN A PIPE AFTER IT HAS BEEN LAID, IT SHALL BE SUBJECT TO REJECTION. ANY CORRECTIVE WORK SHALL BE APPROVED BY THE CITY ENGINEER AND SHALL BE ACCOMPLISHED BY THE CONTRACTOR. PIPE SHALL BE LAID UPGRADE WITH THE SOCKET ENDS OF THE PIPE UPGRADE UNLESS OTHERWISE AUTHORIZED BY THE CITY ENGINEER. PIPE SHALL BE LAID TRUE TO LINE AND GRADE WITH UNIFORM BEARING UNDER THE FULL LENGTH OF THE BARREL OF THE PIPE. SUITABLE EXCAVATION SHALL BE MADE TO RECEIVE THE BELL OR COLLAR, WHICH SHALL NOT BEAR UPON THE SUBGRADE OR BEDDING. ANY PIPE WHICH IS NOT IN TRUE ALIGNMENT OR SHOWS ANY UNDEE SETTLEMENT AFTER LAYING SHALL BE TAKEN UP AND RELAID AT THE CONTRACTOR'S EXPENSE. PIPE SECTIONS SHALL BE LAID AND JOINED IN SUCH A MANNER THAT THE OFFSET OF THE INSIDE OF THE PIPE AT ANY JOINT WILL BE HELD TO A MINIMUM AT THE INVERT. THE MAXIMUM HORIZONTAL OFFSET AT THE INVERT OF THE PIPE SHALL BE 1/4 OF THE INSIDE DIAMETER OF THE PIPE OR 0.02 FEET, WHICHEVER IS SMALLER. THE VERTICAL GRADE SHALL BE +/- 0.02 FEET OF THE DESIGN INVERT. IN JOINING SOCKET PIPE, THE SPIGOT OF EACH PIPE SHALL BE SO SEATED IN THE SOCKET OF THE ADJACENT PIPE AS TO GIVE A UNIFORM ANNUAL SPACE ALL AROUND THE PIPE IN THE SOCKET. UNAVOIDABLE OFFSETS SHALL BE DISTRIBUTED AROUND THE CIRCUMFERENCE OF THE PIPE IN SUCH A MANNER THAT THE MINIMUM OFFSET OCCURS AT THE INVERT. AT THE CLOSE OF WORK EACH DAY, OR WHENEVER THE WORK CEASES FOR ANY REASON, THE END OF THE PIPE SHALL BE SECURELY CLOSED.

**1.2 PVC PIPE**

THIS SPECIFICATION DESIGNATES GENERAL REQUIREMENTS FOR UNPLASTICIZED POLYVINYL CHLORIDE (PVC) PLASTIC CLASS WATER PIPE WITH INTEGRAL BELL AND SPIGOT JOINTS FOR THE CONVEYANCE OF WATER. PIPE SHALL MEET THE REQUIREMENTS OF AWWA C900 OR AWWA C905 "POLYVINYL CHLORIDE (PVC) WATER DISTRIBUTION". ALL PIPE SHALL BE SUITABLE FOR USE AS PRESSURE CONDUIT. PROVISIONS MUST BE MADE FOR EXPANSION AND CONTRACTION AT EACH JOINT WITH AN ELASTOMERIC RING. THE BELL SHALL CONSIST OF AN INTEGRAL WALL SECTION WITH A FACTORY INSTALLED, SOLID CROSS SECTION ELASTOMERIC RING WHICH MEETS THE REQUIREMENTS OF ASTM F-477. THE BELL SECTION SHALL BE DESIGNED TO BE AT LEAST AS HYDROSTATICALLY STRONG AS AND MEET THE REQUIREMENTS OF AWWA C900. ALL SIZES AND DIMENSIONS SHALL BE AS SHOWN IN THIS SPECIFICATION. JOINT DESIGN SHALL MEET QUALIFICATION REQUIREMENTS OF ASTM F3139. EACH PIPE SHALL BE TESTED TO FOUR TIMES THE PRESSURE CLASS OF THE PIPE FOR A MINIMUM OF 30 SECONDS. THE INTEGRAL BELL SHALL BE TESTED WITH THE STANDARD LAYING LENGTHS SHALL BE 10 FEET (1) FOR A SIZE 18 AND 12 FEET (2) FOR A SIZE 24. THE PIPE STIFFNESS USING F/DY FOR PVC CLASS WATER PIPE IS CONTAINED IN THE TABLE BELOW: CLASSDRFDY (PS) 100 25 1291501836420014815 PIPE SHALL WITHSTAND, WITHOUT FAILURE AT 73°F, AN IMPACT OF A FALLING MISSILE, TYP C, AT THE FOLLOWING LEVELS: 24" (1) 24" (2) 24" (3) 24" (4) THERE SHALL BE NO VISIBLE EVIDENCE OF SHATTERING OR SPLUTTING WHEN THE ENERGY IS IMPOSED. RANDOMLY SELECTED SAMPLES TESTED IN ACCORDANCE WITH ASTM D 1599 SHALL WITHSTAND, WITHOUT FAILURE, PRESSURES LISTED BELOW WHEN APPLIED IN 60-70 SECONDS. CLASSMINIMUM BURST PRESSURE AT 73°F (PS) 10053519075520985

ALL PIPE FOR THIS PROJECT SHALL CONFORM TO THE SPECIFICATIONS FOR AWWA C-900, CLASS 150 PVC PIPE MATERIAL FOR DIAMETER SIZES 4 INCHES THROUGH 12 INCHES AND AWWA C-905, DR 18 PVC PIPE MATERIAL FOR DIAMETER SIZES 14 INCHES THROUGH 30 INCHES.

**1.3 DUCTILE IRON FITTINGS**

FITTINGS FOR THE WATER MAINS SHALL BE COMPOSED OF DUCTILE IRON. THE DUCTILE IRON FITTINGS SHALL CONFORM TO ASTM A536. THE FITTINGS SHALL BE CEMENT MORTAR LINING FOR DUCTILE IRON AND GRAY IRON PIPE FITTINGS FOR WATER, LATEST REVISION. THE PRESSURE RATING FOR 3 INCH - 24 INCH DIAMETER SIZES SHALL BE 350 PSI. THE PRESSURE RATING FOR 30 INCH - 48 INCH DIAMETER SIZES SHALL BE 250 PSL. ASPHALTIC SEAL COATING SHALL BE APPLIED TO THE INTERIOR AND EXTERIOR OF THE FITTINGS IN ACCORDANCE WITH ANS/AWWA C104/A21.4.

**1.4 DUCTILE IRON PIPE**

DUCTILE IRON PIPE SHALL BE CLASS 52 OR GREATER. THE DUCTILE IRON PIPE MATERIAL SHALL CONFORM WITH ANS/AWWA C110/A21.10. FLANGED PIPE SHALL CONFORM TO ANS/AWWA C115/A21.15. MECHANICAL JOINT PIPE SHALL CONFORM TO ANS/AWWA C111/A21.11. FASTITE JOINTS SHALL CONFORM WITH ANS/AWWA C111/A21.11. THE CEMENT-MORTAR LINING FOR THE INTERIOR OF THE PIPE SHALL CONFORM TO ANS/AWWA C110/A21.10. THE COATING SHALL CONFORM WITH ANS/AWWA C110/A21.10. DUCTILE IRON PIPELINE SHALL BE WRAPPED WITH A POLYETHYLENE WRAP. DUCTILE IRON PIPELINE SHALL BE BACKFILLED WITH GRANULAR SAND PER THE PIPE TRENCH STANDARD DETAIL.

**1.5 HARDWARE**

ALL NUTS, BOLTS AND MISCELLANEOUS HARDWARE SHALL BE COMPOSED OF 316 STAINLESS STEEL UNLESS OTHERWISE NOTED ON THE PLANS OR APPROVED BY THE CITY ENGINEER. AN ANTI-SEIZE TREATMENT SHALL BE APPLIED TO THE STAINLESS STEEL HARDWARE. A TRIPLOX FLUOROPOLYMER COATING FOR STEEL AND DUCTILE IRON HARDWARE SHALL BE APPROVED AT THE DISCRETION OF THE CITY ENGINEER.

**1.6 RESILIENT WEDGE GATE VALVES**

RESILIENT WEDGE GATE VALVES SHALL CONFORM TO AWWA C509, LATEST EDITION. THE WEDGE SHALL BE FULLY ENCAPSULATED IN THE ELASTOMER, INCLUDING THE GUIDES. THE BRASS STEM NUT SHALL BE RIGIDLY ENCLOSED IN THE WEDGE TO MAINTAIN ALIGNMENT. THE ELASTOMER SHALL BE BONDED TO THE WEDGE. THE VALVE BODY SHALL BE COMPOSED OF DUCTILE IRON. THE STEM SHALL HAVE TWO O-RINGS AND A WIPER ABOVE THE COLLAR AND ONE O-RING BELOW THE COLLAR. STEM SEALS MUST BE REPLACEABLE WITH THE VALVE UNDER PRESSURE.

THE STEM MATERIAL SHALL BE STANDARD BRONZE. STAINLESS STEEL (ANSI-420) SHALL ALSO BE THE WIPERWAY SHALL BE FULLY ENCLOSED TO ALLOW FOR TAPPING USE. NO GROOVES OR DEPRESSIONS SHALL BE ACCEPTABLE FOR USE AS AN ALTERNATIVE, PERMITTED IN THE SEAT AREA.

VALVE BODY AND BONNET SHALL BE ELECTROSTATICALLY APPLIED, FUSION BONDED, EPOXY COATED BOTH INSIDE AND OUT BY THE VALVE MANUFACTURER. THE COATING SHALL MEET THE REQUIREMENTS OF AWWA C-550, LATEST EDITION. COATING SHALL BE APPLIED ONLY AT THE VALVE MANUFACTURER'S FACILITIES. EXTERIOR HARDWARE SHALL BE COMPOSED OF 316 STAINLESS STEEL.

THE BONNET BOLTS SHALL NOT BE EXPOSED TO THE ENVIRONMENT.

O-RING STYLE SEALS SHALL BE USED AS GASKETS ON THE BONNET AND ON THE STUFFING BOX. THE BELOW GATE VALVES SHALL BE SUPPLIED WITH A STANDARD 2" OPERATING NUT.

THE VALVES SHALL BE AN AFC, CLOW, AVK, WATERUSO, M&H VALVE COMPANY, OR AMERICAN DARLING RESILIENT WEDGE GATE VALVE OR AN APPROVED EQUAL. ALL VALVES SHALL BE RESILIENT WEDGE GATE.

**1.8 FLANGED COUPLING ADAPTERS**

FLANGED COUPLING ADAPTERS SHALL BE USED TO JOIN PLAIN END PIPE WITH FLANGED DUCTILE IRON FITTINGS AND VALVES. ADAPTERS SHALL CONFORM TO AWWA SPECIFICATION C-153. BODIES SHALL BE COMPOSED OF DUCTILE IRON CONFORMING TO ASTM A536. THE FLANGED COUPLING ADAPTER SHALL BE CEMENT LINED IN ACCORDANCE WITH ANS/AWWA C104 (ANSI A21.4). THE FLANGED COUPLING ADAPTER SHALL WITHSTAND A WORKING PRESSURE OF 350 PSI.

**1.9 TRANSITION COUPLING**

THE TRANSITION COUPLINGS SHALL BE INSTALLED AS REQUIRED. THE CENTER RINGS SHALL BE CONSTRUCTED OF DUCTILE IRON CONFORMING TO ASTM A536-80, GRADE 65-45-12. THE END RINGS SHALL BE CONSTRUCTED OF DUCTILE IRON CONFORMING TO ASTM A536, GRADE 65-45-12. GASKETS SHALL BE COMPOSED OF VIRGIN STYRENE BUTADIENE RUBBER (SBR) COMPOUNDED FOR WATER AND SEWER SERVICE IN ACCORDANCE WITH ASTM D2000 M&B 910. HARDWARE FOR THE TRANSITION COUPLING SHALL BE 316 STAINLESS STEEL. THE COATING FOR THE DUCTILE IRON TRANSITION COUPLING SHALL BE FUSION BONDED EPOXY. THE TRANSITION COUPLING SHALL BE CAPABLE OF SUSTAINING A WORKING PRESSURE OF 250 PSI.

**1.10 RESTRAINED JOINT FITTINGS**

MECHANICAL JOINT RESTRAINT SHALL BE INCORPORATED INTO THE DESIGN FOR THE FOLLOWER GLAND. THE GRIPPING OR RESTRAINING MECHANISM SHALL TRANSMIT UNIFORM RESTRAINING PRESSURE AROUND THE CIRCUMFERENCE OF THE PIPE, THUS AVOIDING POINT LOADING OR PIPE DISTORTION. THIS RESTRAINING PROCESS SHALL BE KEPT SEPARATE FROM THE MECHANICAL JOINT SEALING PROCESS AND NOT A PART OF THE SEALING FUNCTION. ALL COMPONENTS SHALL BE MANUFACTURED OF DUCTILE IRON CONFORMING TO ASTM A536-80, GRADE 65-45-12.

THE RESTRAINING TWIST OFF NUT BOLT SYSTEM SHALL HAVE A TORQUE LIMITING FEATURE DESIGNED TO BREAK OFF AT 75 TO 90 FT.-LBS. OF TORQUE TO INSURE PROPER ACTUATING OF RESTRAINING DEVICES. BOTH THE TWIST OFF NUT AND THE REMOVAL NUT SHALL BE THE SAME SIZE AS TEE-BOLT NUT. HARDWARE SHALL BE COMPOSED OF 304 STAINLESS STEEL.

THE GLAND SHALL BE SUCH THAT IT CAN REPLACE THE STANDARDIZED MECHANICAL JOINT GLAND AND CAN BE USED WITH THE STANDARDIZED MECHANICAL JOINT BELL CONFORMING TO ANS/AWWA C111/A21.11, C110/A21.10 AND C153/A21.53 OF THE LATEST REVISION.

**GENERAL CONDITIONS**

**7. TRAFFIC CONTROL:**

THE CONTRACTOR IS REQUIRED TO SUBMIT A TRAFFIC CONTROL PLAN, PREPARED BY A CALIFORNIA LICENSED ENGINEER TO THE CITY OF WESTMORLAND FOR REVIEW AND APPROVAL. PRIOR TO COMPLETING DEMOLITION OR EXCAVATION WORK IN STREET OR ALLEY AREAS WITHIN THE CITY OF WESTMORLAND, THE CONTRACTOR SHALL ADVISE ALL BUSINESS, RESIDENTIAL, INSTITUTIONS AND GOVERNMENTAL AGENCIES NEAR THE VICINITY OF THE PROJECT OF IMPENDING CONSTRUCTION ACTIVITIES AT LEAST TWO (2) WORKING DAYS PRIOR TO THE COMMENCEMENT OF ANY WORK. THE TRAFFIC CONTROL PLAN SHALL BE PREPARED IN CONFORMANCE WITH THE STATE OF CALIFORNIA DEPARTMENT OF TRANSPORTATION, "MANUAL OF TRAFFIC CONTROLS FOR CONSTRUCTION AND MAINTENANCE WORK ZONES", LATEST EDITION.

THE CONTRACTOR SHALL PROVIDE AND MAINTAIN ALL NECESSARY TRAFFIC CONTROL TO PROTECT AND GUIDE TRAFFIC FOR ALL WORK IN THE CONSTRUCTION AREA. THE CONTRACTOR SHALL BE RESPONSIBLE FOR ALL EXPENSES RELATIVE TO TRAFFIC CONTROL. ALL TRAFFIC CONTROLS SHALL BE CLEARLY POSTED WITH SIGNS PRIOR TO THE BEGINNING OF ANY WORK. ALL TRAFFIC RESTRICTIONS LISTED HEREIN ARE TO SUPPLEMENT OTHER TRAFFIC REGULATIONS OF THE CITY OF WESTMORLAND AND ARE NOT INTENDED TO DELETE ANY PART OF THESE REGULATIONS. THE CONTRACTOR SHALL ATTEMPT TO MAINTAIN LOCAL ACCESS TO ALL PROPERTIES ON THE PROJECT AT THE END OF EACH WORKING DAY, WHEN POSSIBLE. ANY STREET CLOSURE SHALL BE APPROVED BY THE CITY ENGINEER AND PUBLIC WORKS MANAGER.

**8. SIGNS:**

STOP SIGNS AND ALL OTHER TRAFFIC SIGNS SHALL BE MOVED IF NECESSARY DURING THE CONSTRUCTION PROCESS AND BE REPOSITIONED TEMPORARILY IN A LOCATION DETERMINED BY THE ENGINEER. STOP SIGNS SHALL NOT BE REMOVED FROM SERVICE, BUT RATHER RELOCATED TO A VISIBLE LOCATION. OTHER SIGNS LOCATED WITHIN THE CONSTRUCTION AREA SHALL BE STORED BY THE CONTRACTOR DURING THE CONSTRUCTION PHASE OF THE PROJECT. AT THE CONCLUSION OF THE PROJECT, ALL SIGNS SHALL BE POSITIONED IN A PERMANENT LOCATION AS DETERMINED BY THE ENGINEER.

**9. BARRICADES:**

DURING THE INSTALLATION OF THE P.C.C. CONCRE